


Sec. 8

T. 8 S., R. 1 E., W. M.

Permit # R 8149 44946  
R 6699 42324

IN NAME OF JAMES M. HEATER

SCALE 1" = 400'

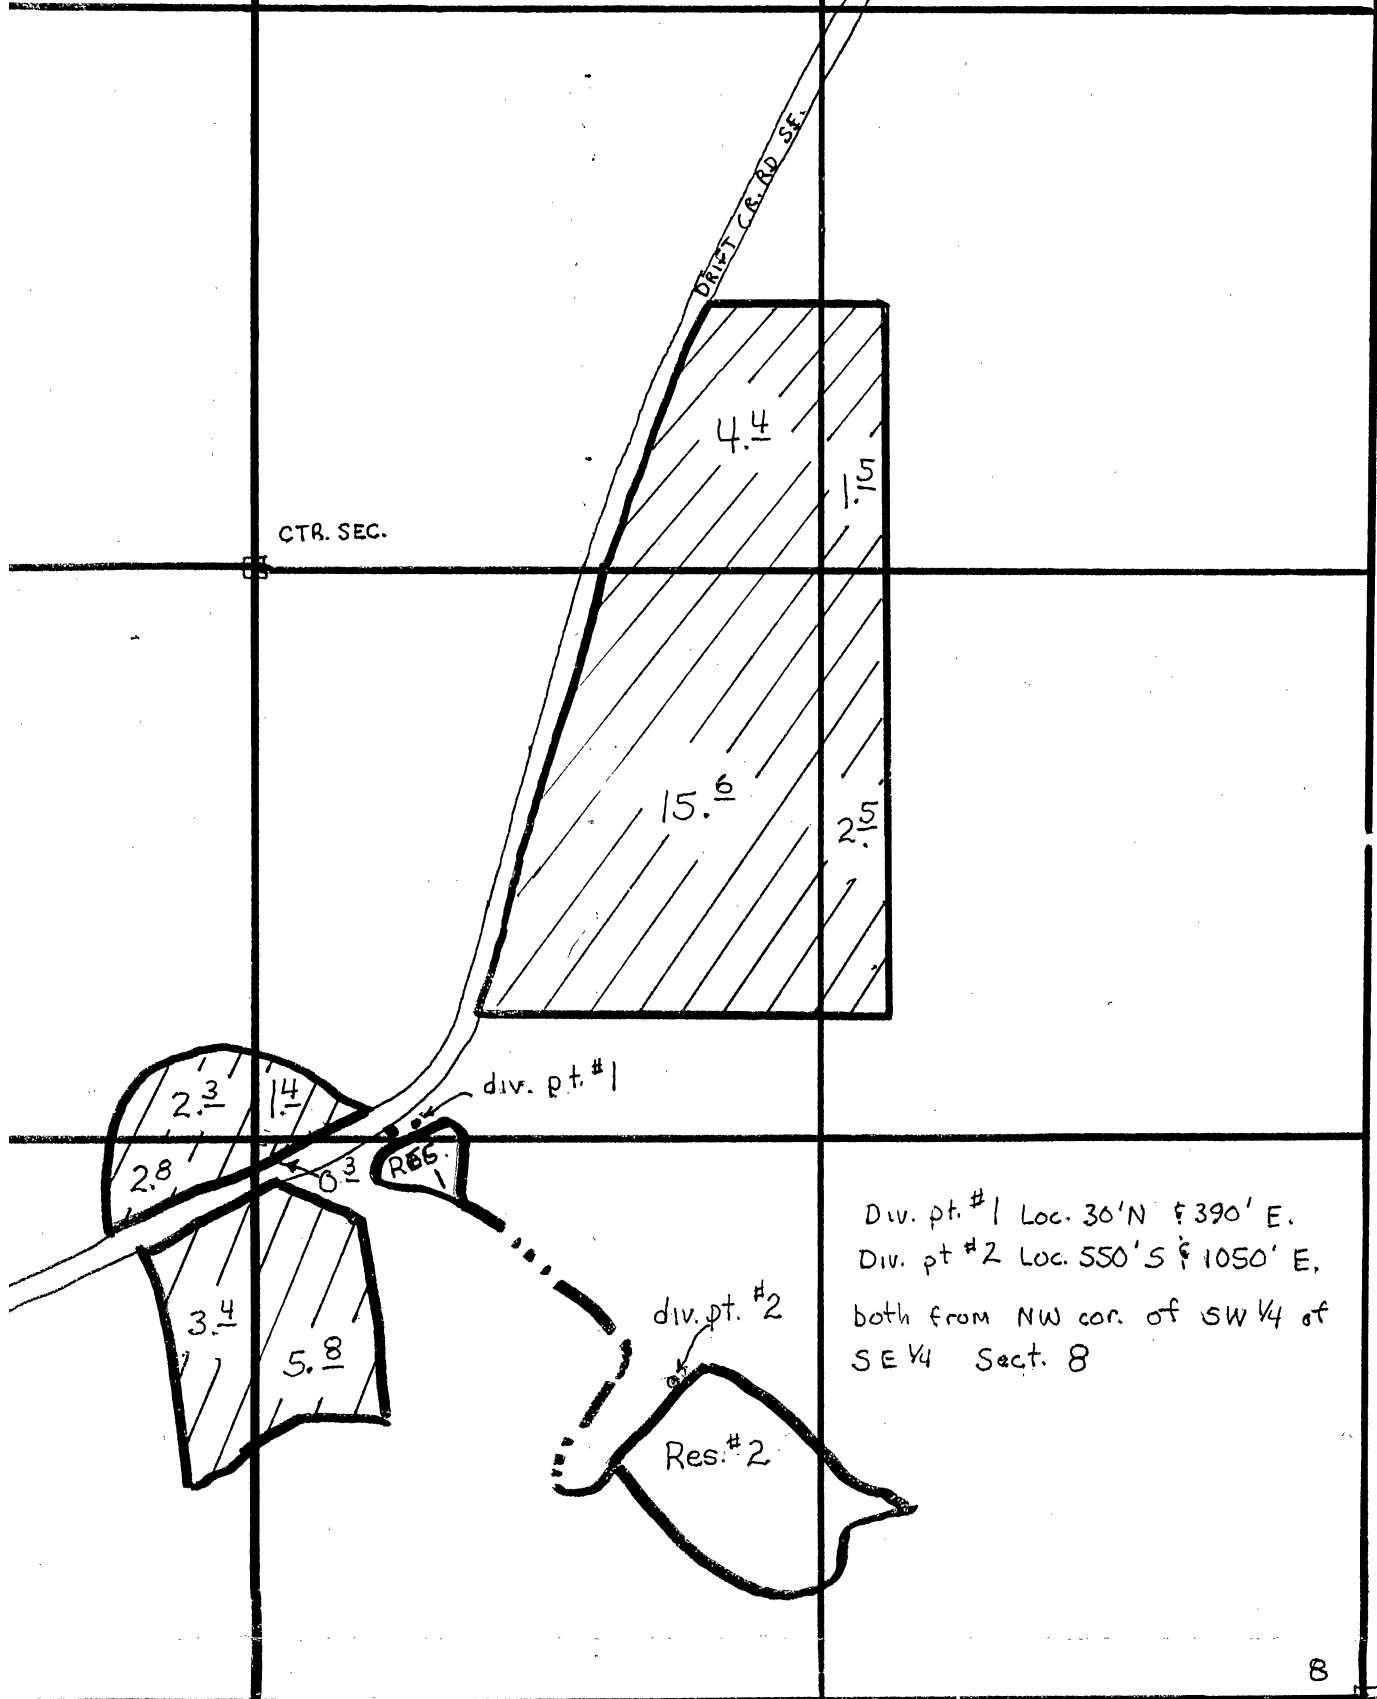

Div. pt. #1 Loc. 30' N & 390' E.  
Div. pt #2 Loc. 550' S & 1050' E,  
both from NW cor. of SW 1/4 of  
SE 1/4 Sect. 8