


T.37S.,R.7W.,W.M.

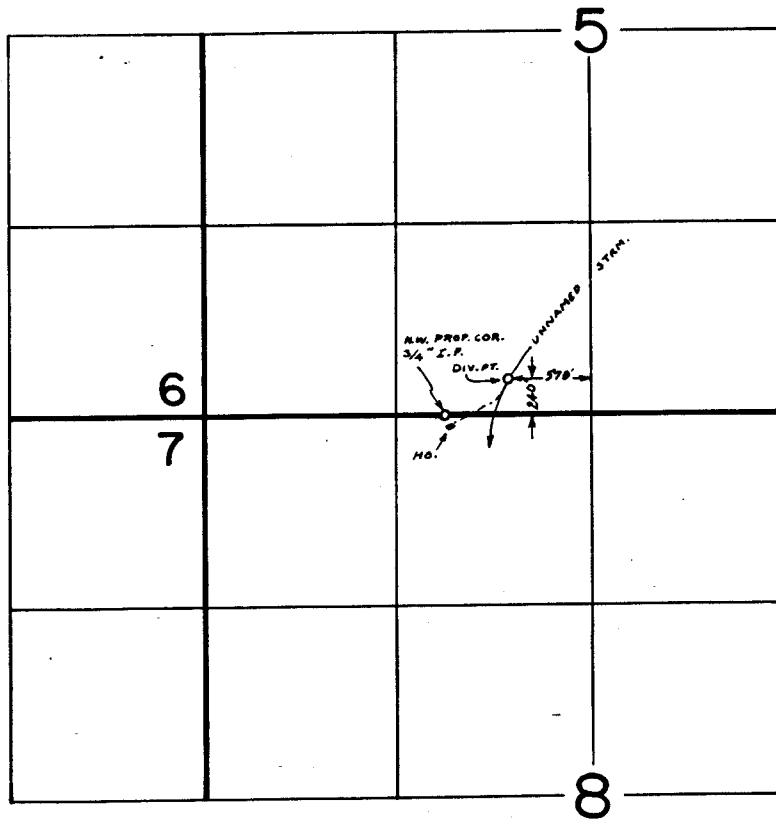

RECEIVED
OCT 1 1981
WM. DIST. 14
GRANTS PASS, ORE

FINAL PROOF SURVEY
UNDER

Application No. 56364 Permit No. 42363
IN NAME OF

ROBIN MORANETZ

Surveyed JUL. 27 1978, by B. SUND

P.T.S. - 1978 - 14 - C