
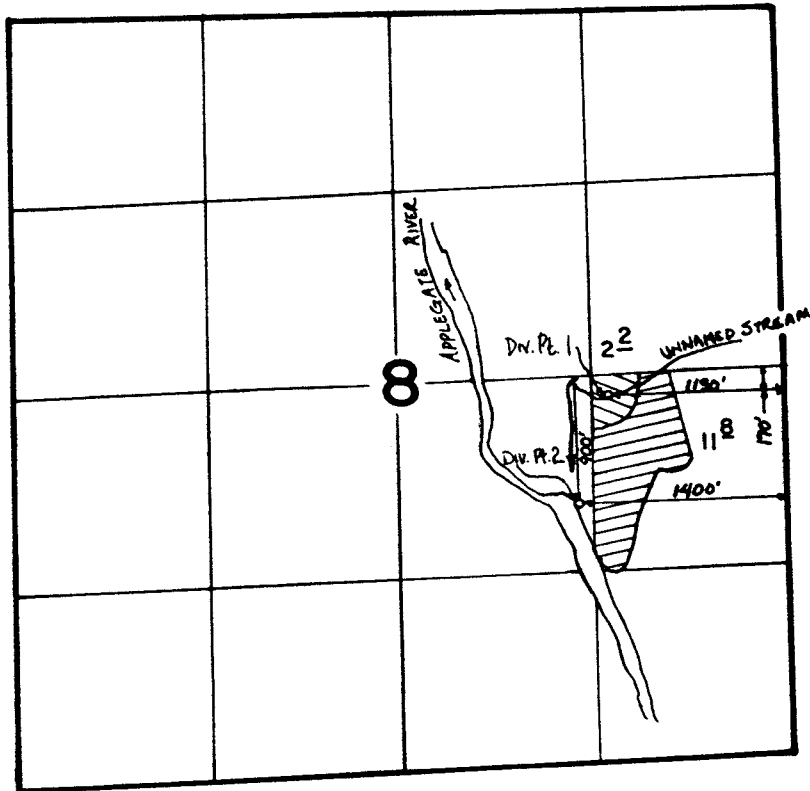



T. 37 S., R. 6 W., W.M.

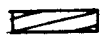

-  Primary from Div. Pt. 2
-  Primary from Div. Pt. 1, Supplemental from Div. Pt. 2

FINAL PROOF SURVEY UNDER

Application No. .56.339. Permit No. ...42365.....
IN NAME OF

.....CARLA VAN DOORN.....

Surveyed .OCT..18., 1983., by .B.S. JAMES.....

RECEIVED

MAR 15 1989

W.M. DIST. 14
GRAND B. CASE, GEE