


T. 32S. R. 4W. Sec. 6

THIS MAP PREPARED BY:

Clair M. Youngquist

FROM INFORMATION FURNISHED BY
THE APPLICANT.

Application No. 56377
Permit No. 42383

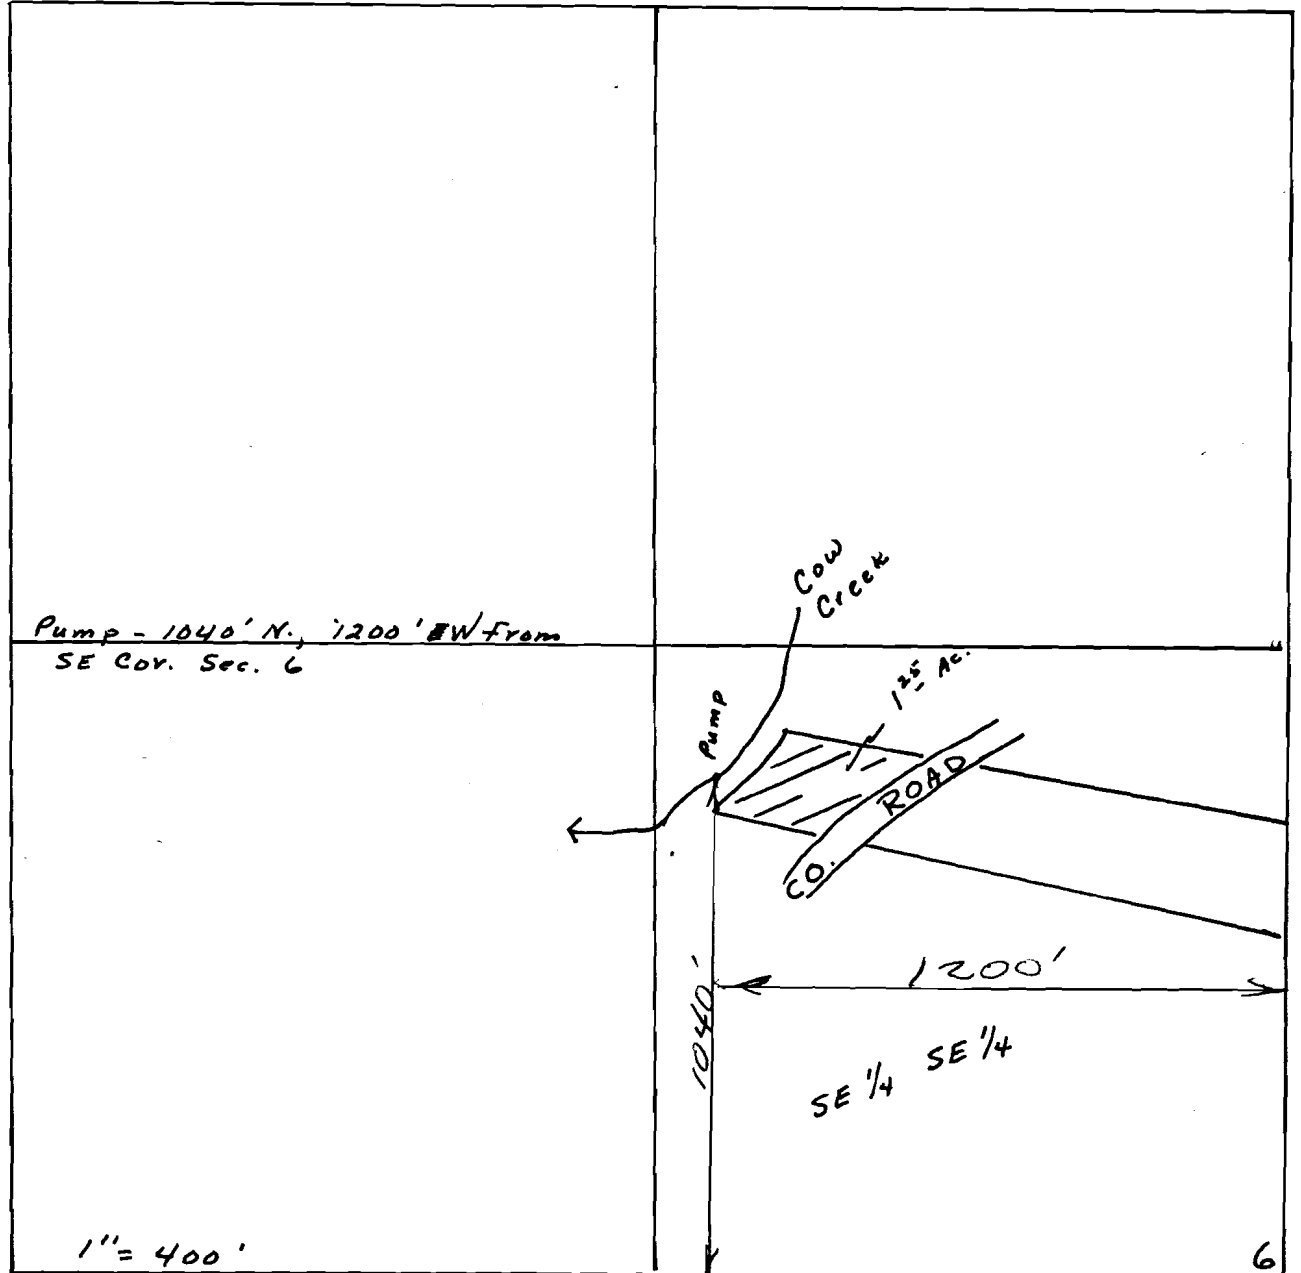

6 5
7 8