


WATER RIGHTS SURVEY LOCATED IN
 N.E. 1/4 OF SECTION 11 T27S, R13W, WM
 COOS COUNTY OREGON

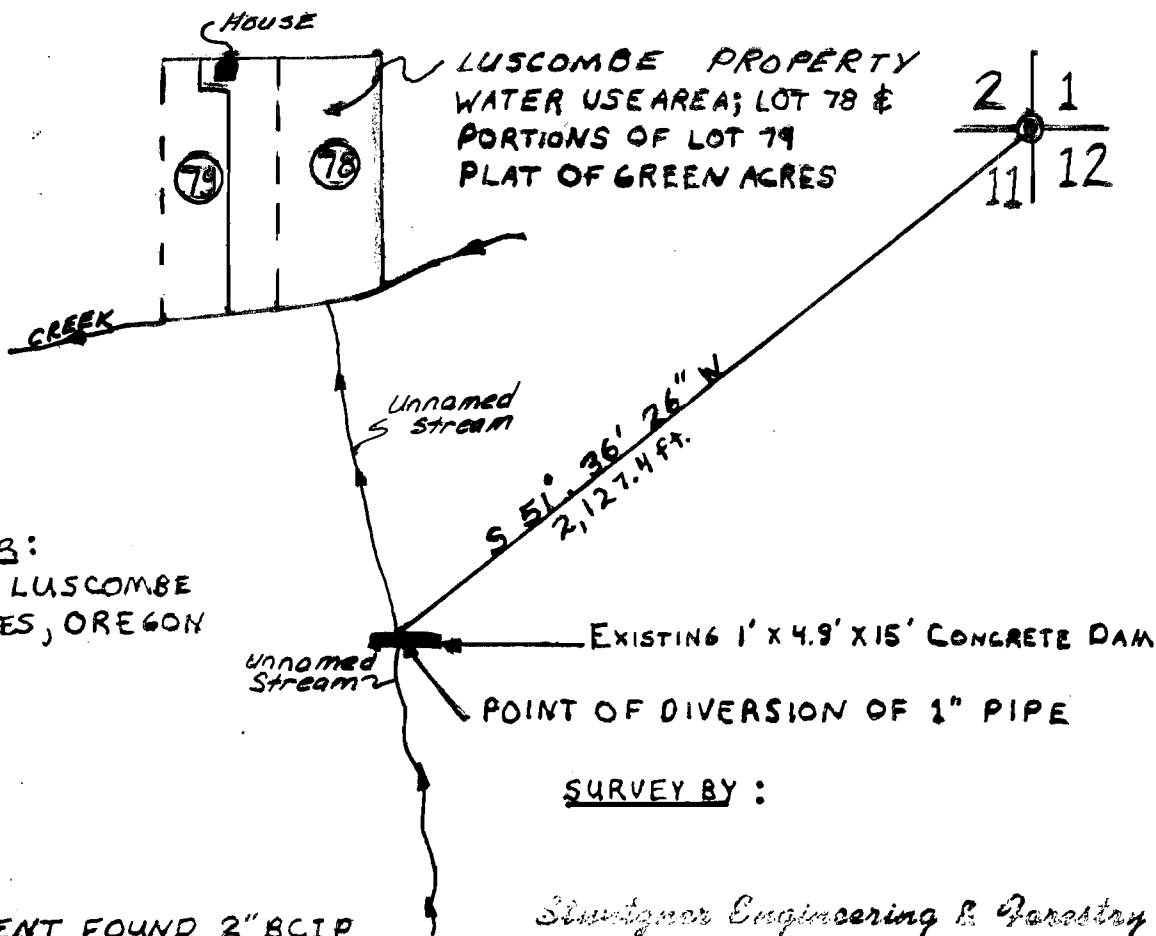

SURVEY FOR:
 CALVIN S. LUSCOMBE
 GREEN ACRES, OREGON

LEGEND

- ⊙ MONUMENT FOUND 2" BCIP
- SCALE 1" = 500'
- CREEK
- JULY 11 1977

SURVEY BY:

Stuntzner Engineering & Forestry
 323 Park
 P.O. Box 118
 Coos Bay, Oregon 97420



BASIS OF BEARING SOLAR OBSERVATION

MAP FOR APPLICATION No. 56378

Application No. 56378
 Permit No. 42454