


30646

T. 8 S. R. 19 E. W. M.

Application No. 55996
Permit No. 42532

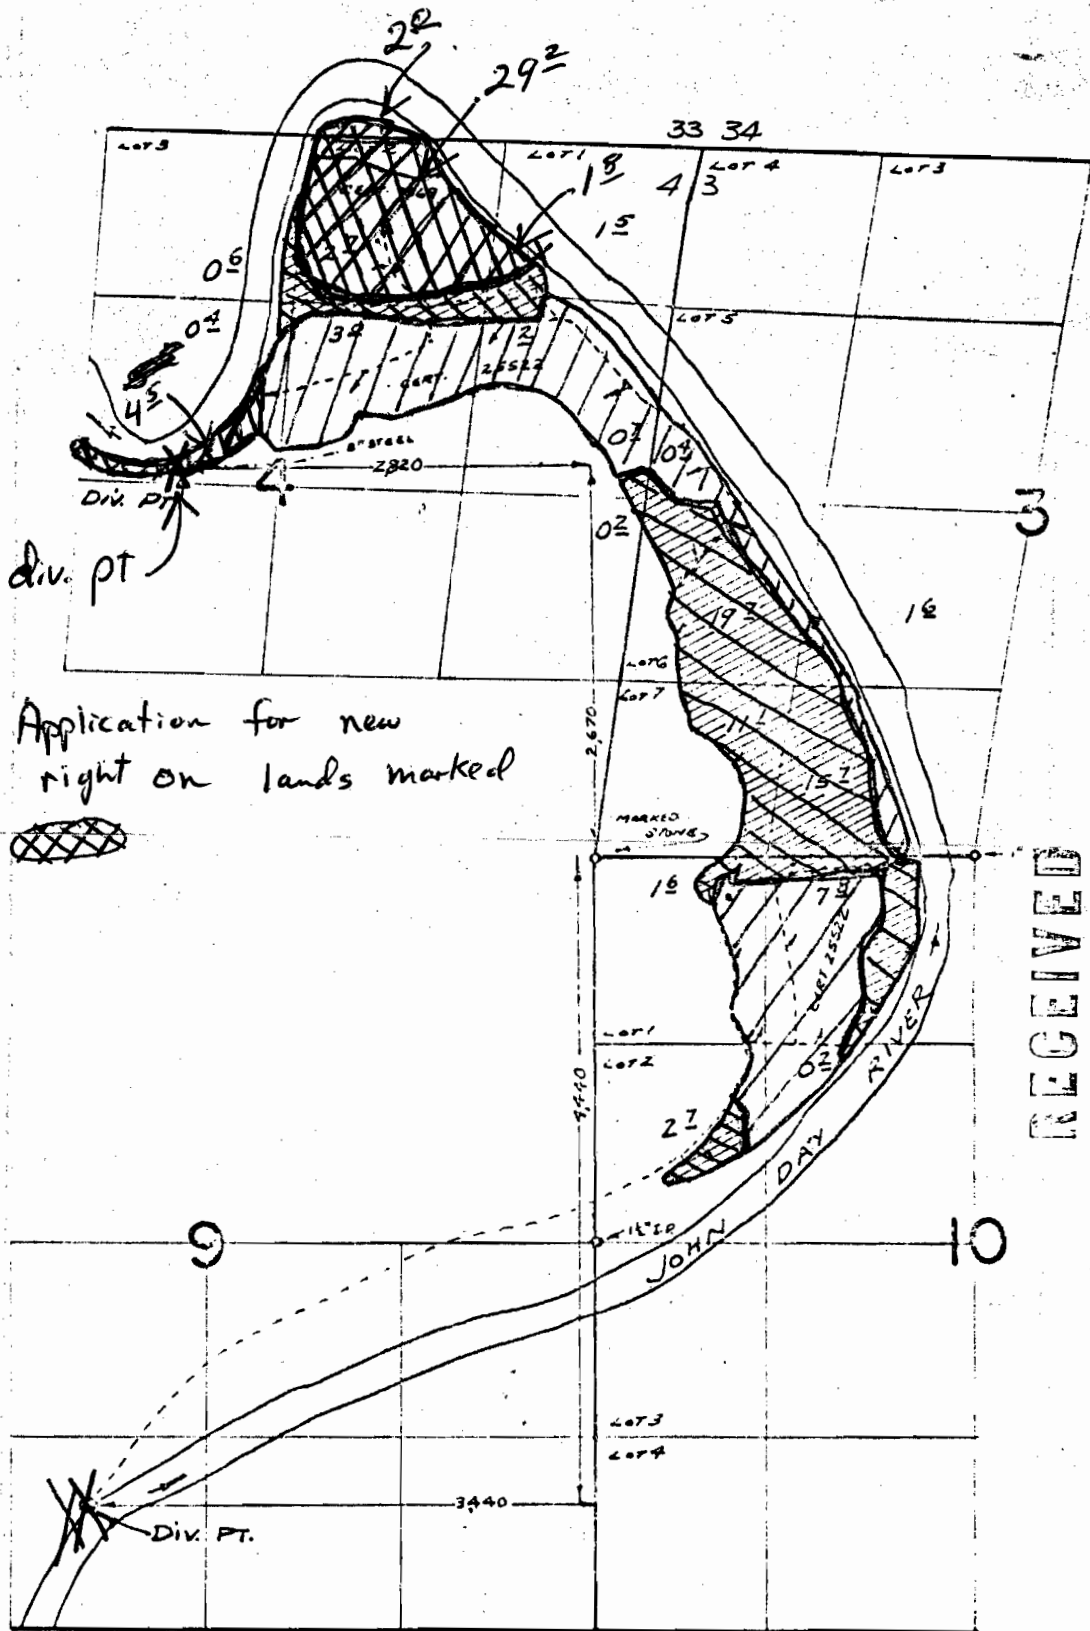

Application for new right on lands marked



RECEIVED

MAY 31 1977

WATER RESOURCES DEPT
SALEM, OREGON

I approve *Art McGreer*

FINAL PROOF SURVEY

SCALE 4" = 1 mile

I assisted

Bob Mann

ARTHUR L. MCGREER

Nov 3, 71 R. MUCKEN