


T.34S., R.5 W., W.M.

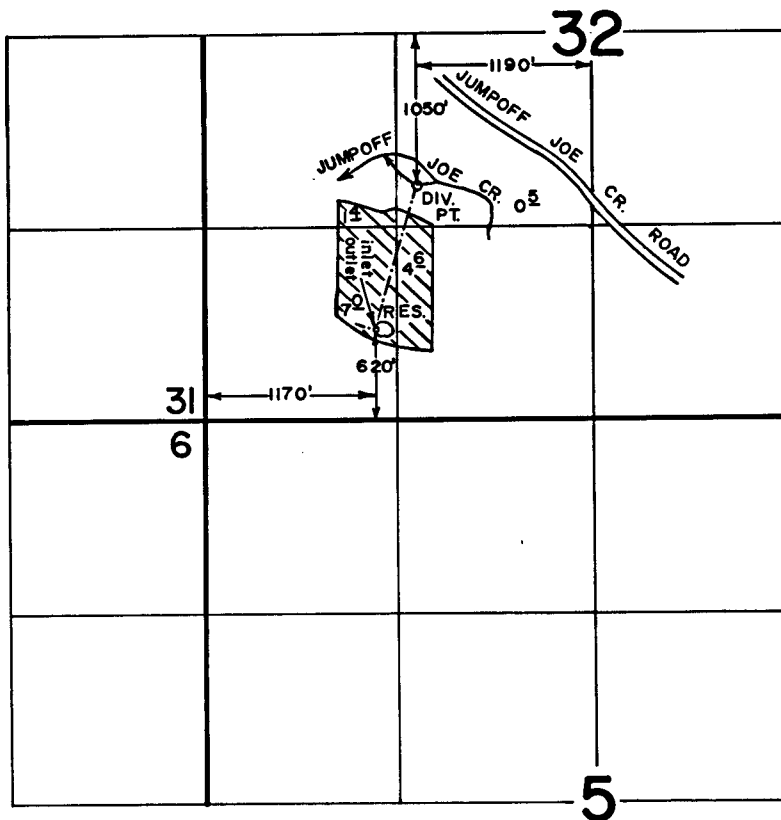

RECEIVED

FEB 02 1987

WM. DIST. 14
GRANTS PASS, ORE.

FINAL PROOF SURVEY
UNDER

R-55636 R-6748

Application No. 55637 Permit No. 42543
IN NAME OF

.....*Dale and Sharolyn Pugh*.....

Surveyed SEPT. 14, 1982, by B. S. JAMES.....

SCALE: 4" = 1 MILE

179-133R

TWB