


T.35S., R.6W., W.M.

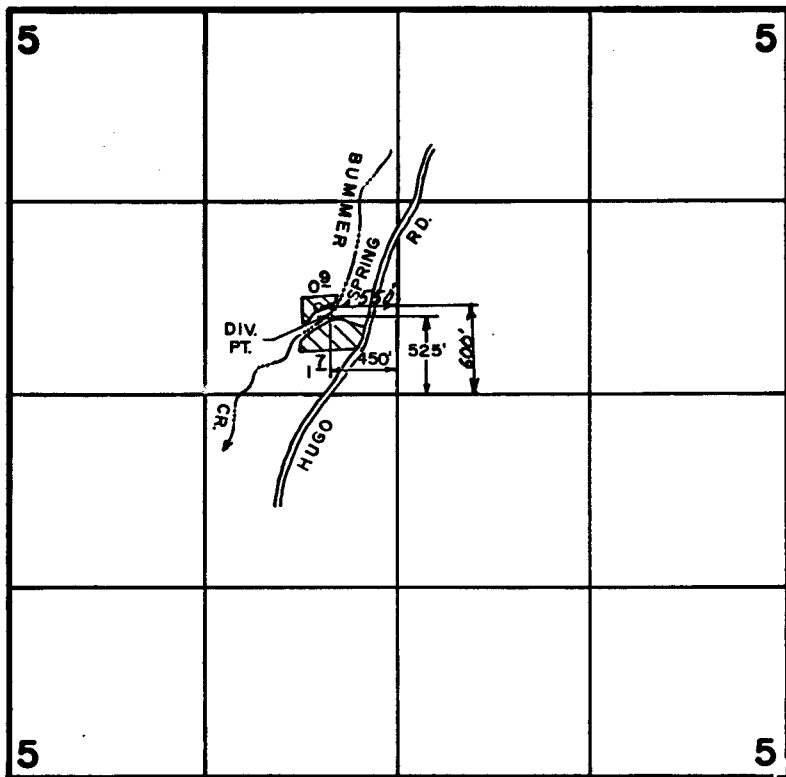

B.C.

FEB 12 1988

WATER RESOURCES DEPT.
SALEM, OREGON

FINAL PROOF SURVEY

UNDER

TRANSFER NO. 4165

Application No. 56465 Permit No. 42545.....

IN NAME OF

..... **PAUL E. JONAS**

Surveyed SEPT. 28 19.82, by B. SUZIE JAMES.

SCALE: 4" = 1 MILE

RECEIVED

AUG 10 1987

WATER RESOURCES DEPT.
SALEM, OREGON

179-150L TWB