


T. 36 S., R. 5 W., W.M.

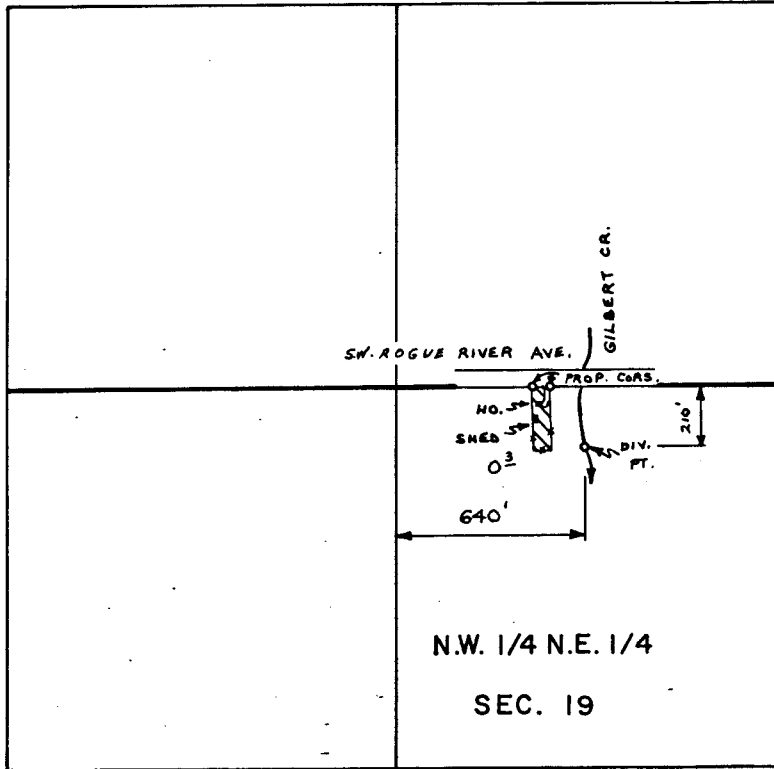

SCALE : 1" = 660 FT.

FINAL PROOF SURVEY
UNDER

Application No. 56674 Permit No. 42549
IN NAME OF
VICTOR NIELSEN

Surveyed OCT. 23 1978, by B. SUND

RECEIVED
OCT 1 1981
WM. DIST. 14
GRANTS PASS, ORS

D.H.M.
P.T.S. - 1978 - 14 - D