T. 40 S., R. 8 W., W. M.

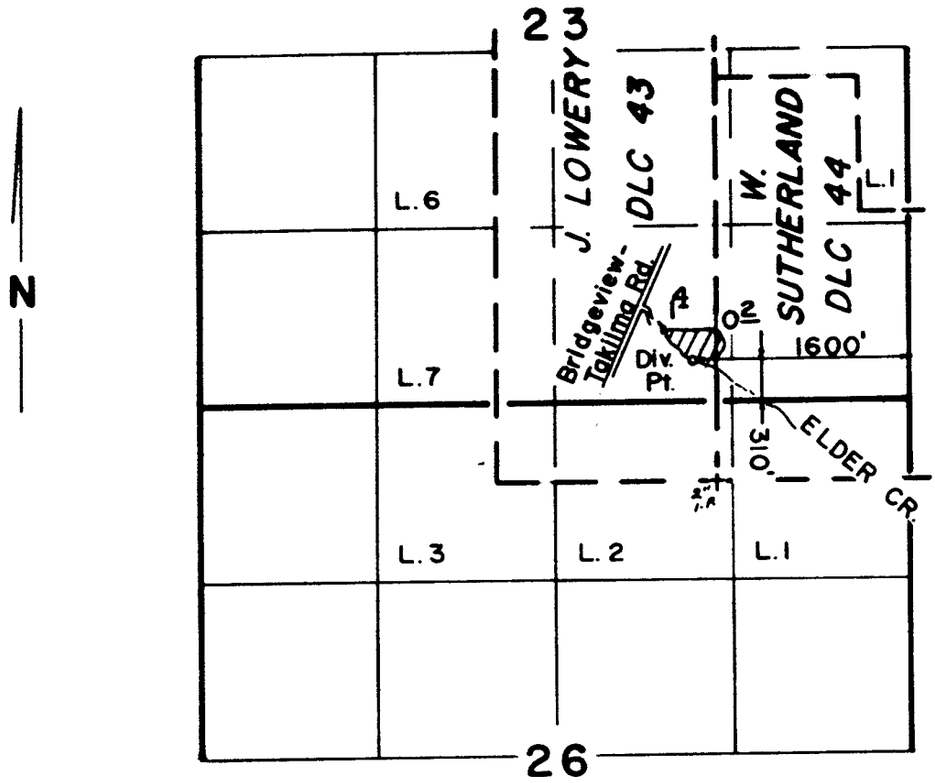

Scale: 1" = 1320'

FINAL PROOF SURVEY
UNDER

RECEIVED
MAR 06 1989

Application No. 55455 Permit No. 42552
IN NAME OF

WAYNE C. FILLOON

Surveyed APR. 2 1986, by R. S. JAMES

4133-139-1886 LAJ