


T.38 S., R.7 W., W.M.

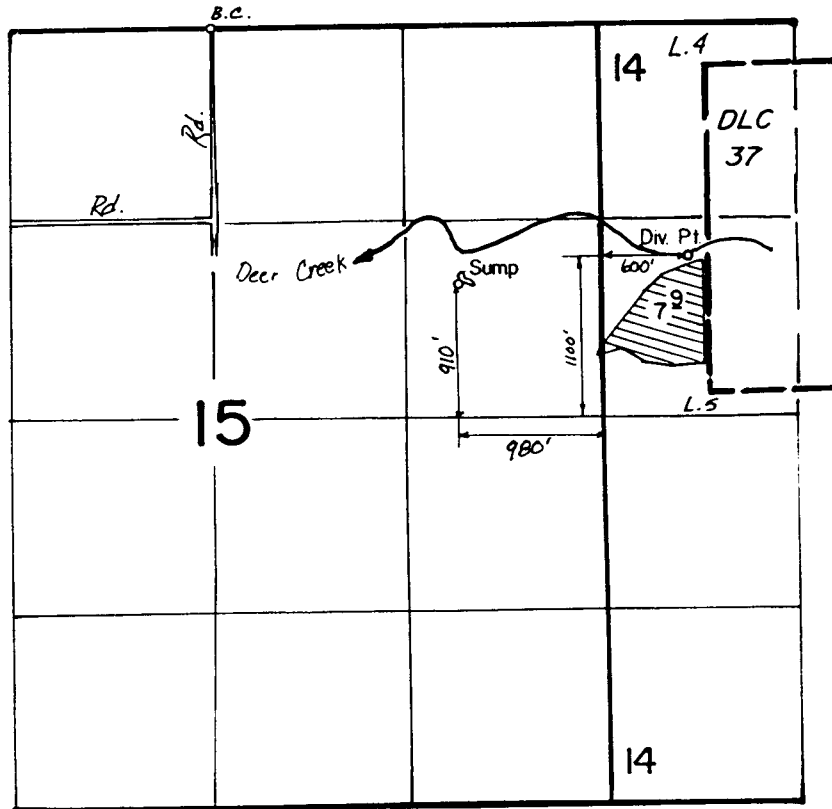

COPY

**FINAL PROOF SURVEY
UNDER**

TRANSFER NO. 3784

Application No. 56765 Permit No. 42588

IN NAME OF

HOWARD BARBER

Surveyed OCT. 27, 1983, by B.S. JAMES

MAR 15 1989

178-1734 me 2/1/84