


# T.35S., R.6 & 7W., W.M.

RECEIVED

SEP 1 1987

WM. DIST. 14  
GRANTS PASS OFF.

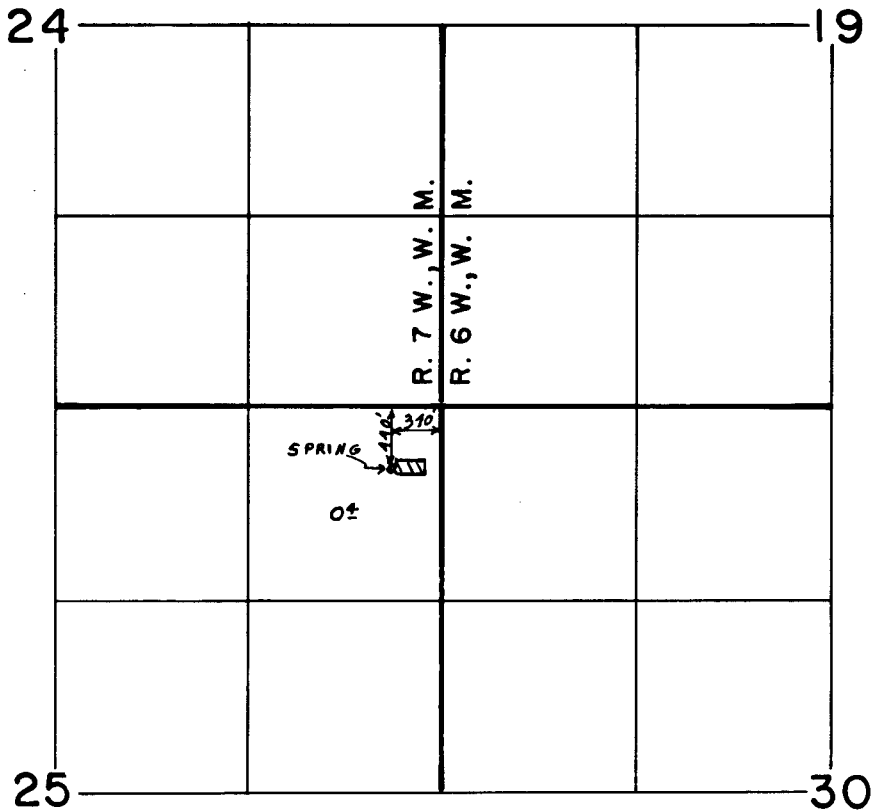

SCALE: 4" = 1 Mile

## FINAL PROOF SURVEY UNDER

Application No. 56.7.7.0 Permit No. 42591....  
IN NAME OF

.....ERVIN J. FUSILIER.....

Surveyed Q.C.T. 24 19.8.5, by B.S. JAMES...