


RECEIVED
AUG 13 1974
STATE ENGINEER
SALEM OREGON

T.9S. R.6W. W.M.

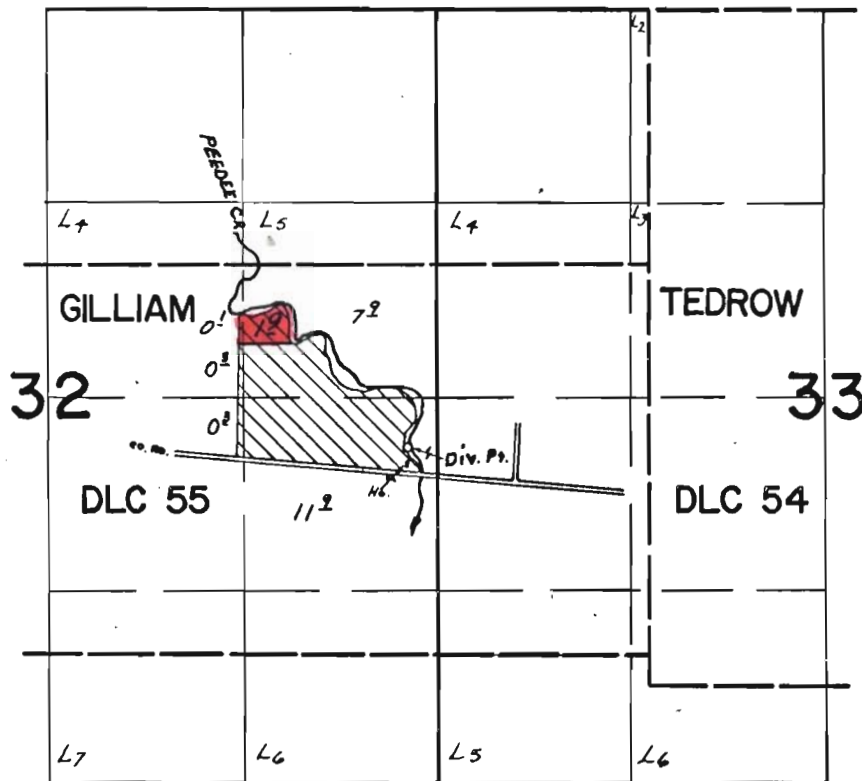

Div. Pt. Loc: 1250' S. & 1650' W. from NE cor. Gilliam DLC 55

FINAL PROOF SURVEY

UNDER

Application 52311
Permit 42631

Application No. 43613 Permit No. 32151
IN NAME OF

ROBERT V. FORD

Surveyed MARCH 28, 1973, by R. MUCKEN