


T. 36 S., R. 5 W., W. M.

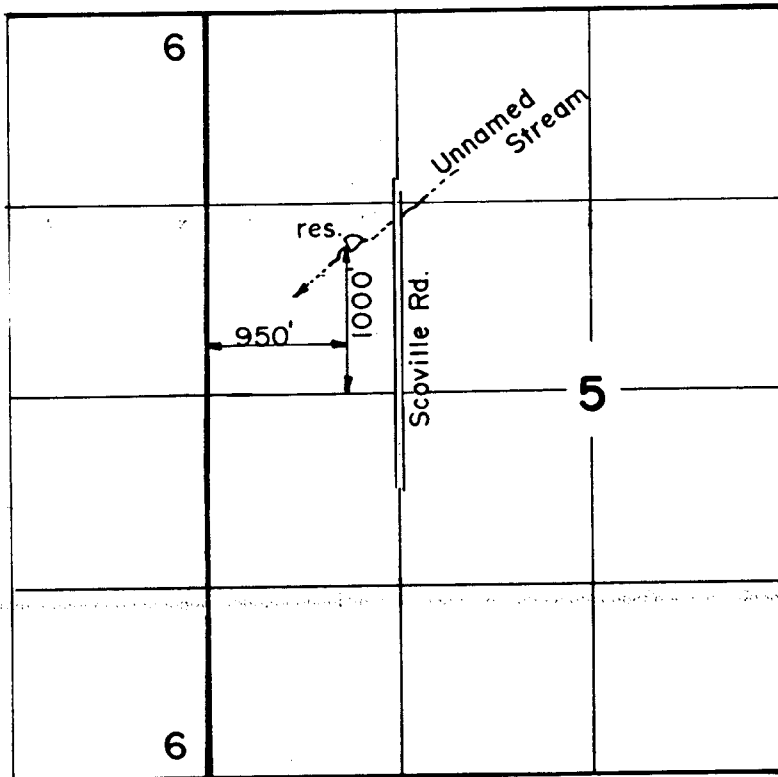

Scale: 1" = 1320'

RECEIVED  
 AUG 31 1990  
 W.M. DIST. 14  
 GRANTS PASS, ORE.

**FINAL PROOF SURVEY**  
 UNDER

R-56700      R-6768  
 Application No. 56701      Permit No. 42658  
 IN NAME OF

.....BARBARA B. BERNHART.....

Surveyed JUL...30. 19.87., by B...S...JAMES...