


T. 36 S., R. 5 W., W.M.

RECEIVED  
JUN 16 1982  
WM. DIST. 14  
GRANTS PASS, ORE

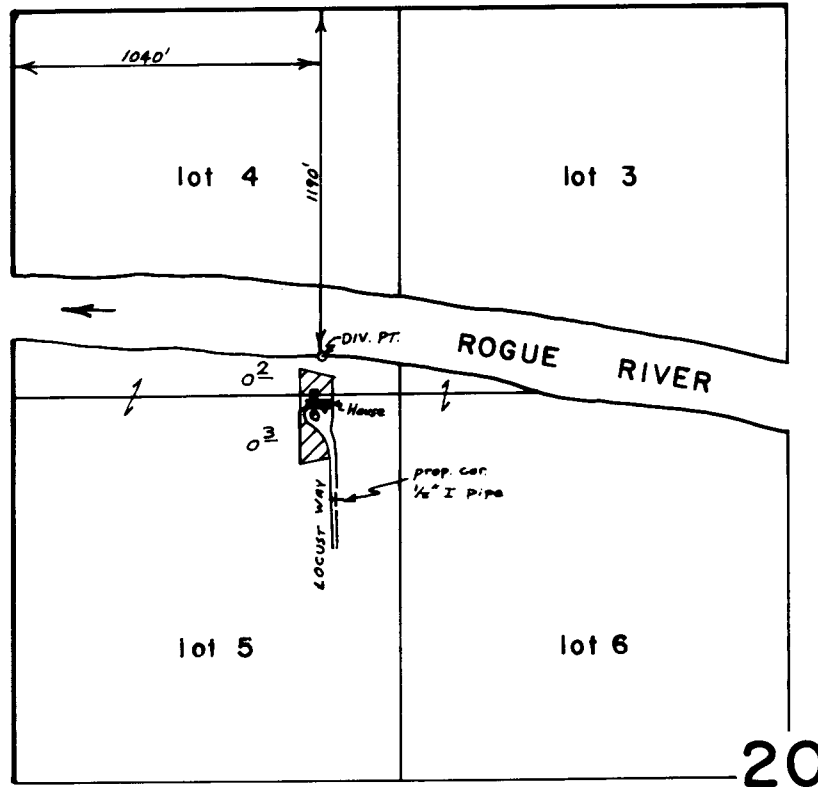

scale : 1" = 660'

**FINAL PROOF SURVEY**  
UNDER

Application No. 55613.... Permit No. 42.66.7....  
IN NAME OF

JACK MAHNKEN.....

Surveyed JUNE 22, 1978 by B.R.SUND.....