


T.39 S., R.5 W., W.M.

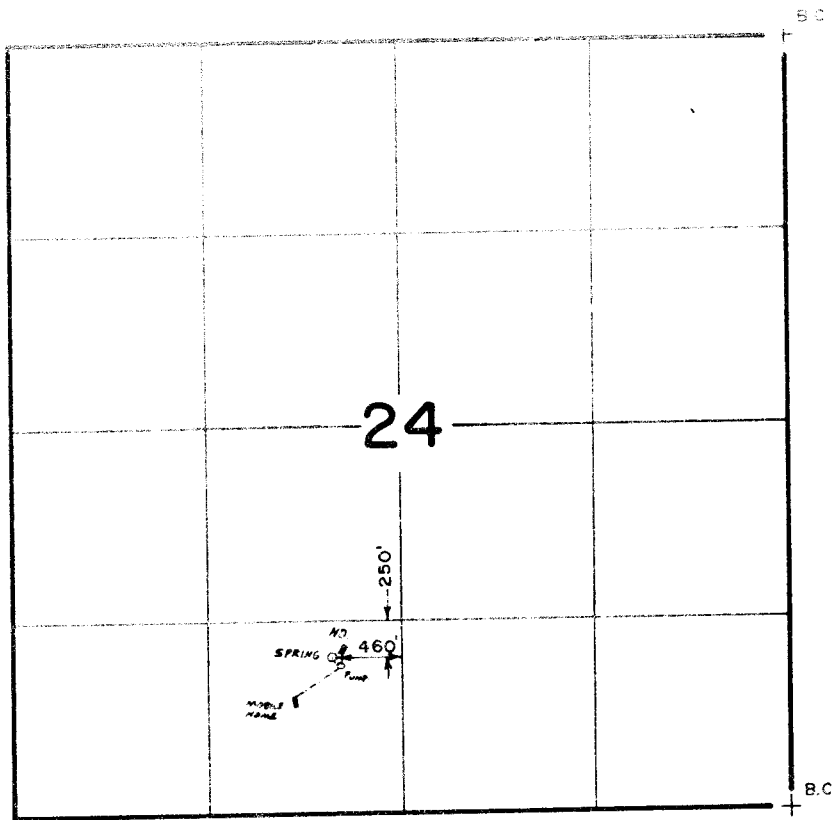

RECEIVED

MAR 9 1984

WM. DIST. 14
OREGON PASS. ORE.

FINAL PROOF SURVEY
UNDER

Application No. **56848**, Permit No. **42669**.....
IN NAME OF

JIMMY or MILDRED PASTORE

Surveyed **May 13, 1982**, by **B.R. SUND**.....

Scale 4" = 1 Mile

179-96R

bsj