


T. 36 S., R. 7 W., W. M.

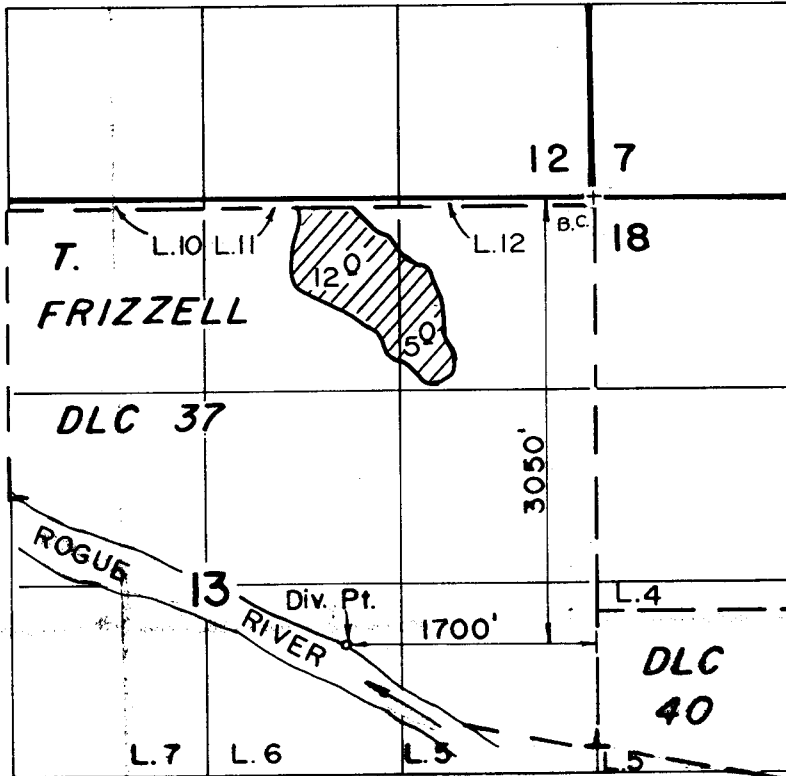

Scale: 1" = 1320'

RECEIVED  
JUL 16 1990

WM. DIST. 14  
GRANTS PASS, ORE.

**FINAL PROOF SURVEY**  
UNDER

Application No. 56292 Permit No. 42734  
IN NAME OF

ANTHONY CORNELLA

Surveyed Oct. 6 1988, by B. S. JAMES.

B50-6-16 LMS