


T. 38S., R. 8W., W.M.

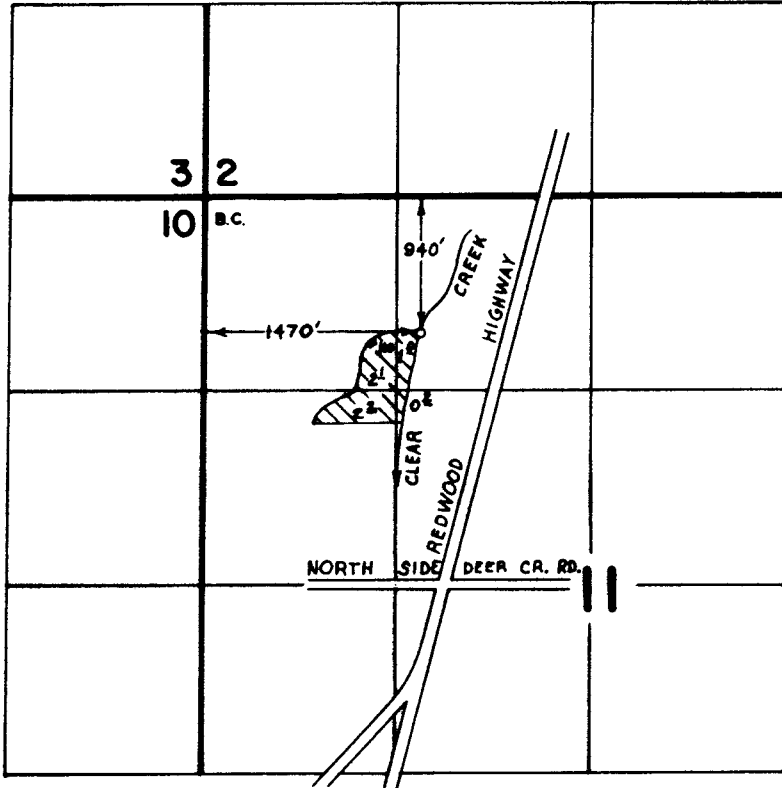

MAY 23 1989

REGISTERED
SURVEYOR

FINAL PROOF SURVEY
UNDER

Application No. 56838 Permit No. 42736
IN NAME OF

EUGENE L. VANDERMARK

Surveyed OCT. 26. 19. 83, by B. S. JAMES

SCALE: 4" = 1 MILE

179-195L TWB