


42740

T.36S.,R.5W.,W.M.

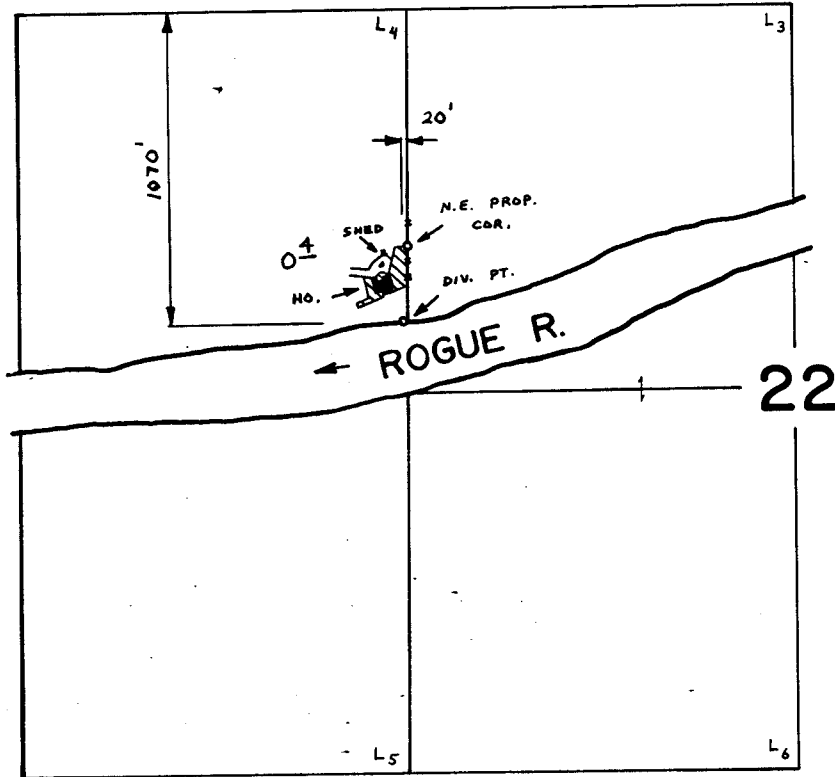

RECEIVED  
 OCT 1 1981  
 WM. DIST. 14  
 GRANTS PASS, ORE.

SCALE: 1" = 660 FT.

**FINAL PROOF SURVEY**  
UNDER

Application No. 57043 Permit No. 42740  
IN NAME OF

THERON A. CROREY

Surveyed JUN. 22 1978, by B. SUND

D.H.M.  
P.T.S. - 1978 - 14 - A