


T.7N. R.2W. W.M.

Application No. 55540

Permit No. 42754

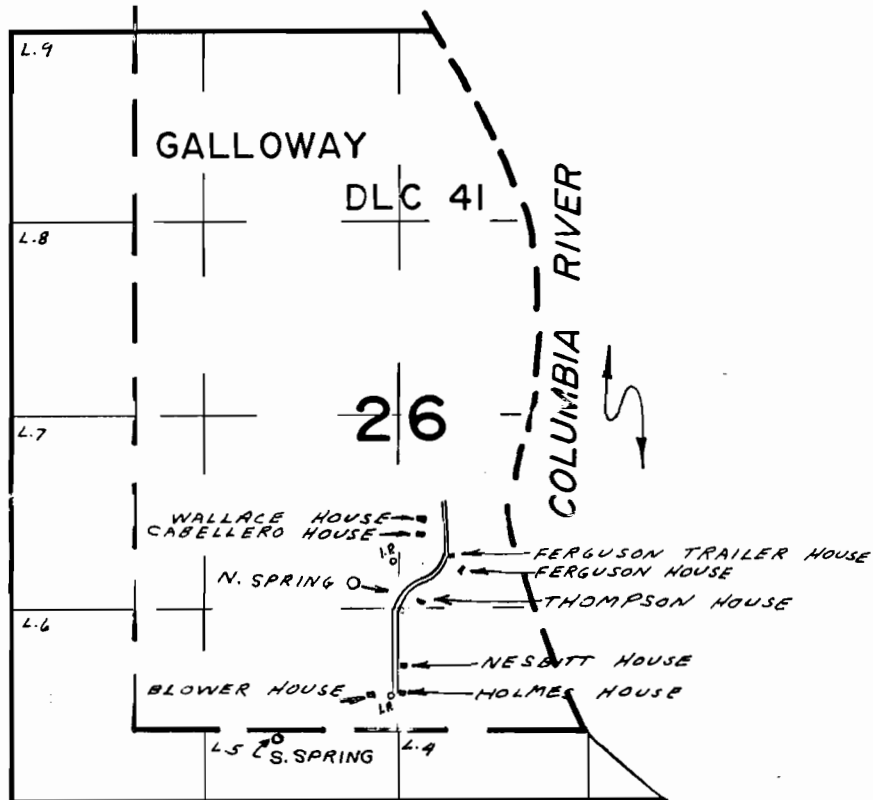

NOTE: HOUSES WEST OF ROAD NOT INCLUDED UNDER PERMIT NO. 29797.

N. SPRING LOC. 1480'N & 310'W FROM S. 1/4 COR. SEC. 26  
S. SPRING LOC. 466'N & 793'W " " " " " "

**FINAL PROOF SURVEY**  
UNDER

Application No. 40003... Permit No. 29797...  
IN NAME OF

.....CHARLES M. KELLEY.....

Surveyed JULY 1... 1976., by L.H. NUNN.....