



Permit 42802

T. 36 S., R. 6 W., W.M.

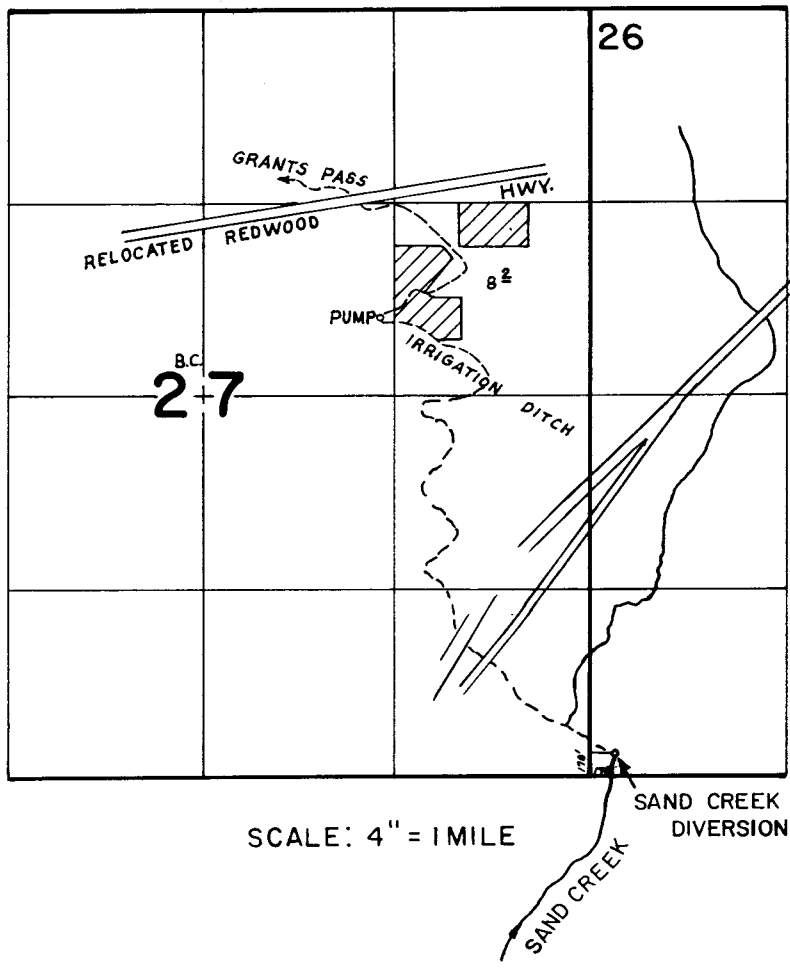

SCALE: 4" = 1 MILE

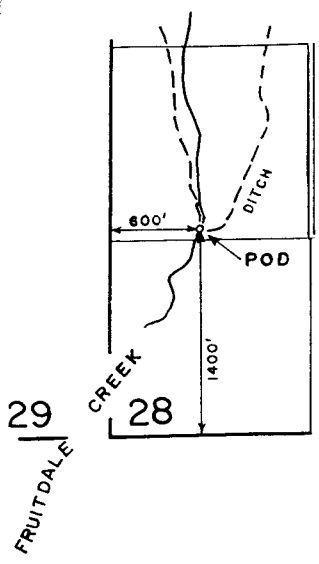

FINAL PROOF SURVEY UNDER

Application No. 53865 Permit No. 42802 - Cont. 73978
IN NAME OF

L. H. DOERFLING

Surveyed JAN. 25, 1984, by B. S. JAMES