


Permit: S 42807
Volume: 8
Strm: OAK FLAT CR
Trib: ILLINOIS R
Priority: 12/20/77

T.37S., R.9 W., W.M.

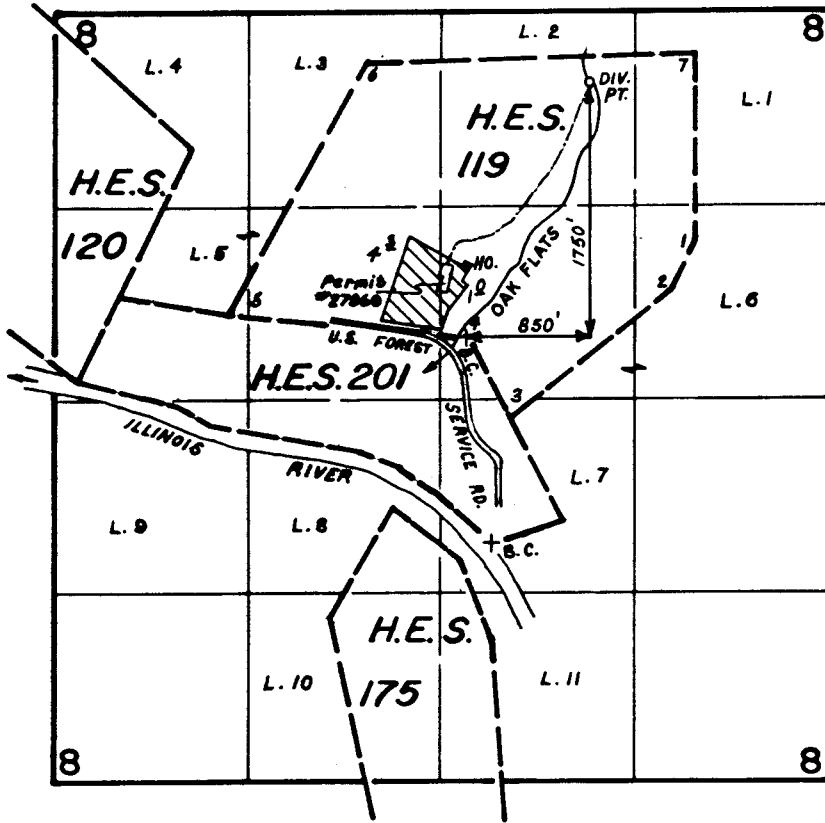

SCALE: 1" = 1320'

MAILED
JUL 11 1989
STATE DEPT. OF
NATURAL RESOURCES

FINAL PROOF SURVEY UNDER

Application No. 56938 Permit No. 42807
IN NAME OF

JERRY SORENSEN

Surveyed MAR. 2 1984, by B. S. JAMES