


25 30  
36 31

30 29  
31 32

Application No. R-56402, 56993  
Permit No. R7023, 42851

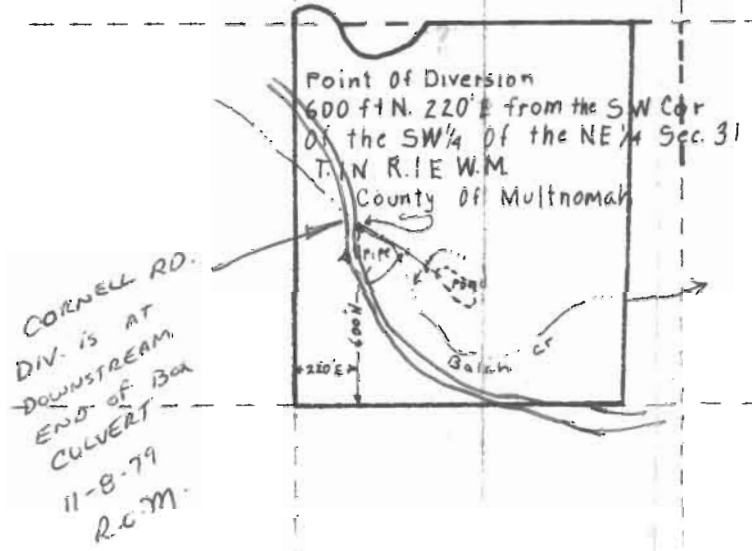

36 31  
1 6

PITTOCK BIRD SANCTUARY

Scale 1" = 660'

U. S. DEPARTMENT OF AGRICULTURE  
SOIL CONSERVATION SERVICE

DESIGNED BY

*W. J. Cagle*

APPROVED BY

CHECKED BY

DRAWING NO.

DATE:

SHEET

OF