


T26S R12W  
Sec 20  
Scale 1"=400'

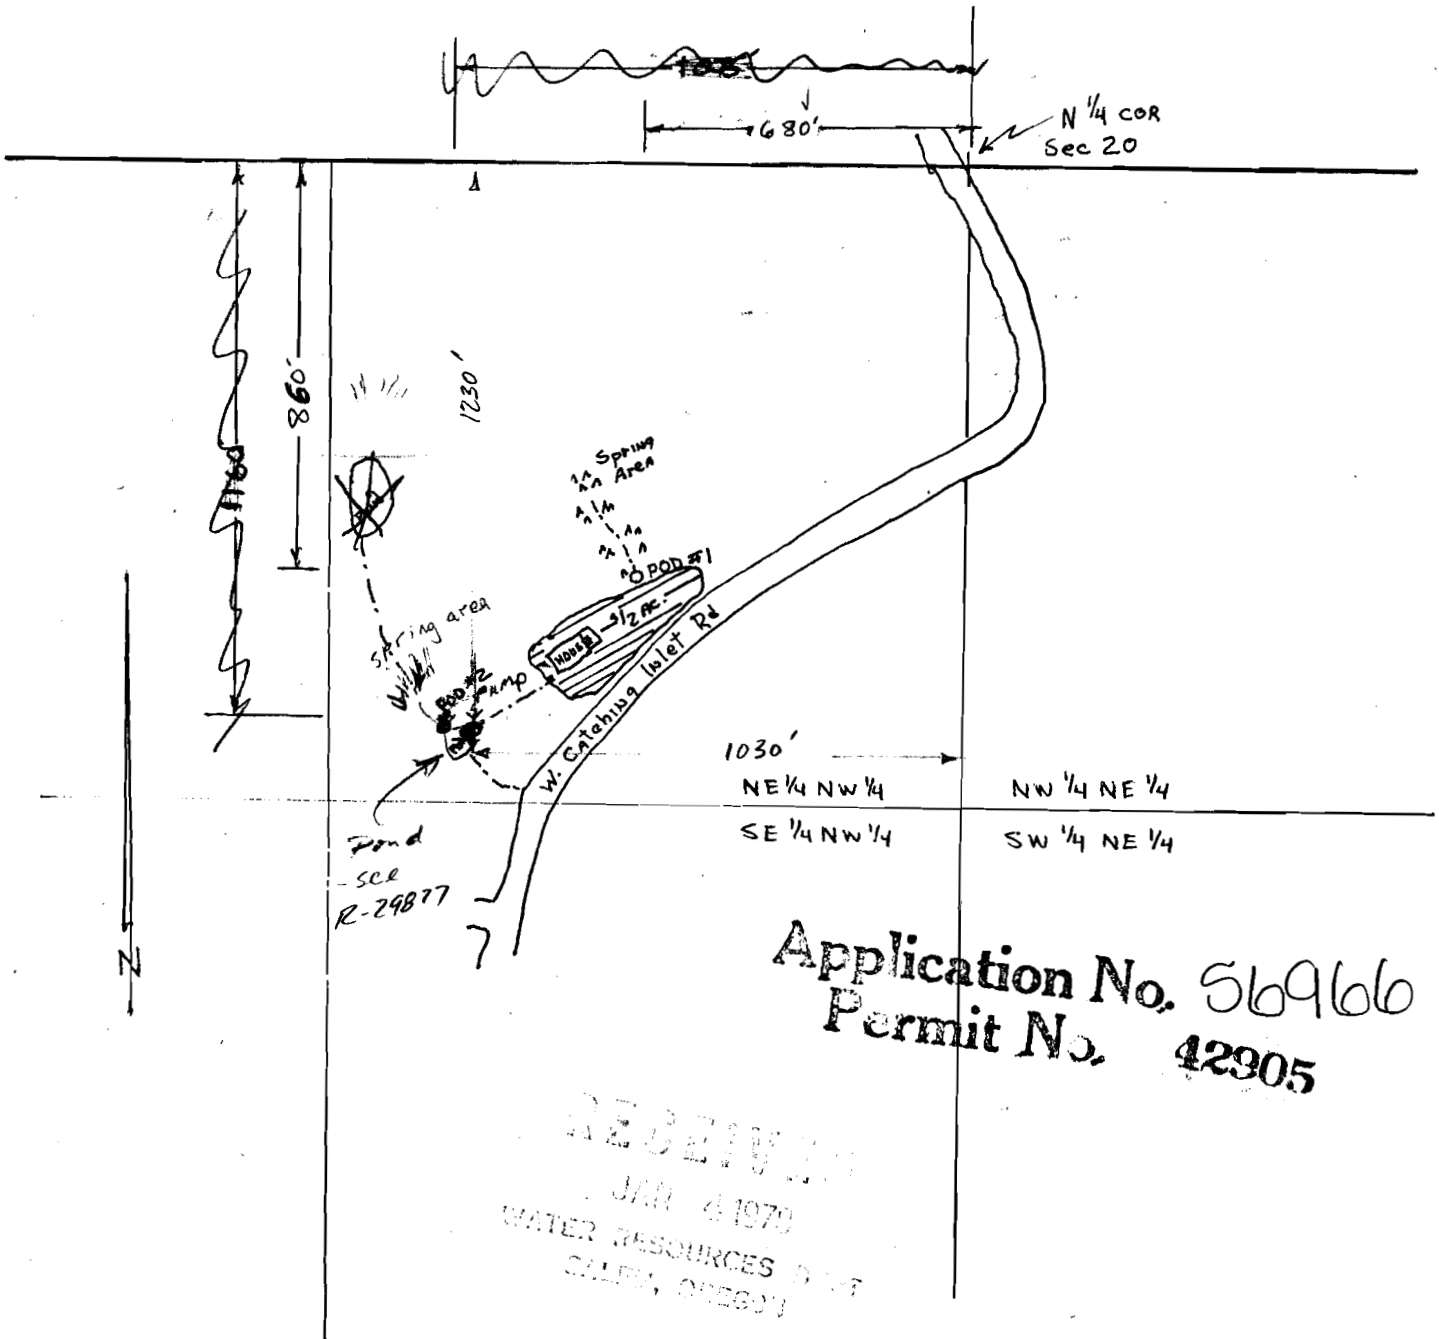

Application No. 56966  
Permit No. 42905

RECEIVED  
JUN 4 1970  
WATER RESOURCES DEPT  
