
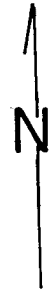


T.36S., R. 7 W., W.M.

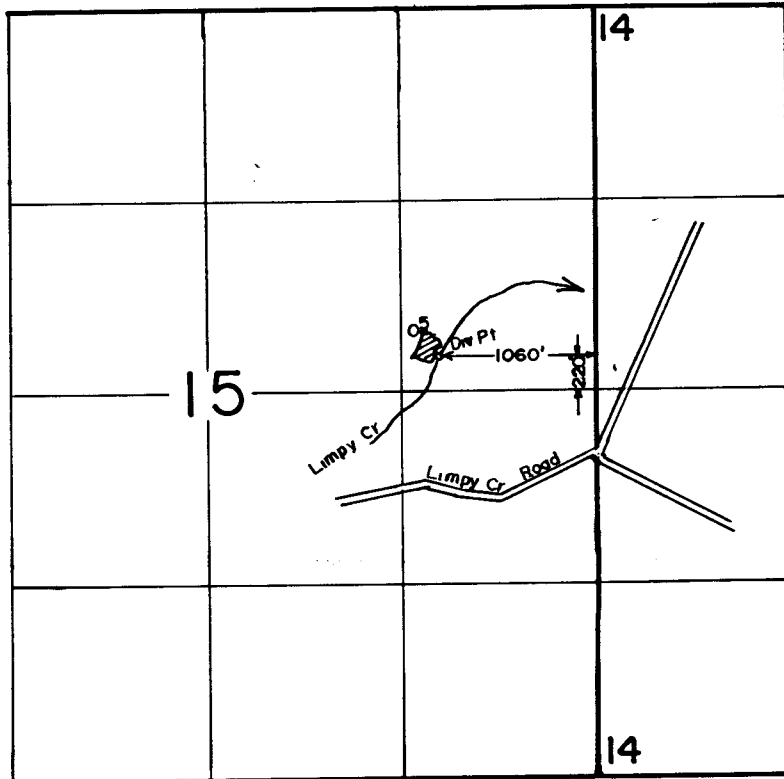

RECEIVED
JUL 16 1990
WM. DIST. 14
BRANTS PASS, OR.

SCALE: 1" = 1320'

FINAL PROOF SURVEY
UNDER

Application No. 57073... Permit No. 42949.....
IN NAME OF

...DIXIE R. & MARY NELL DENTON..

Surveyed MAY 25... 1989., by B.S. JAMES.....

41033-179-167L

12-22-89 DM