


Application No. 57106  
Permit No. 42964

T. 26 S. R. 4 W. Pt. N.W. SEC 19

RE: GIOVINE, LEWIS C.

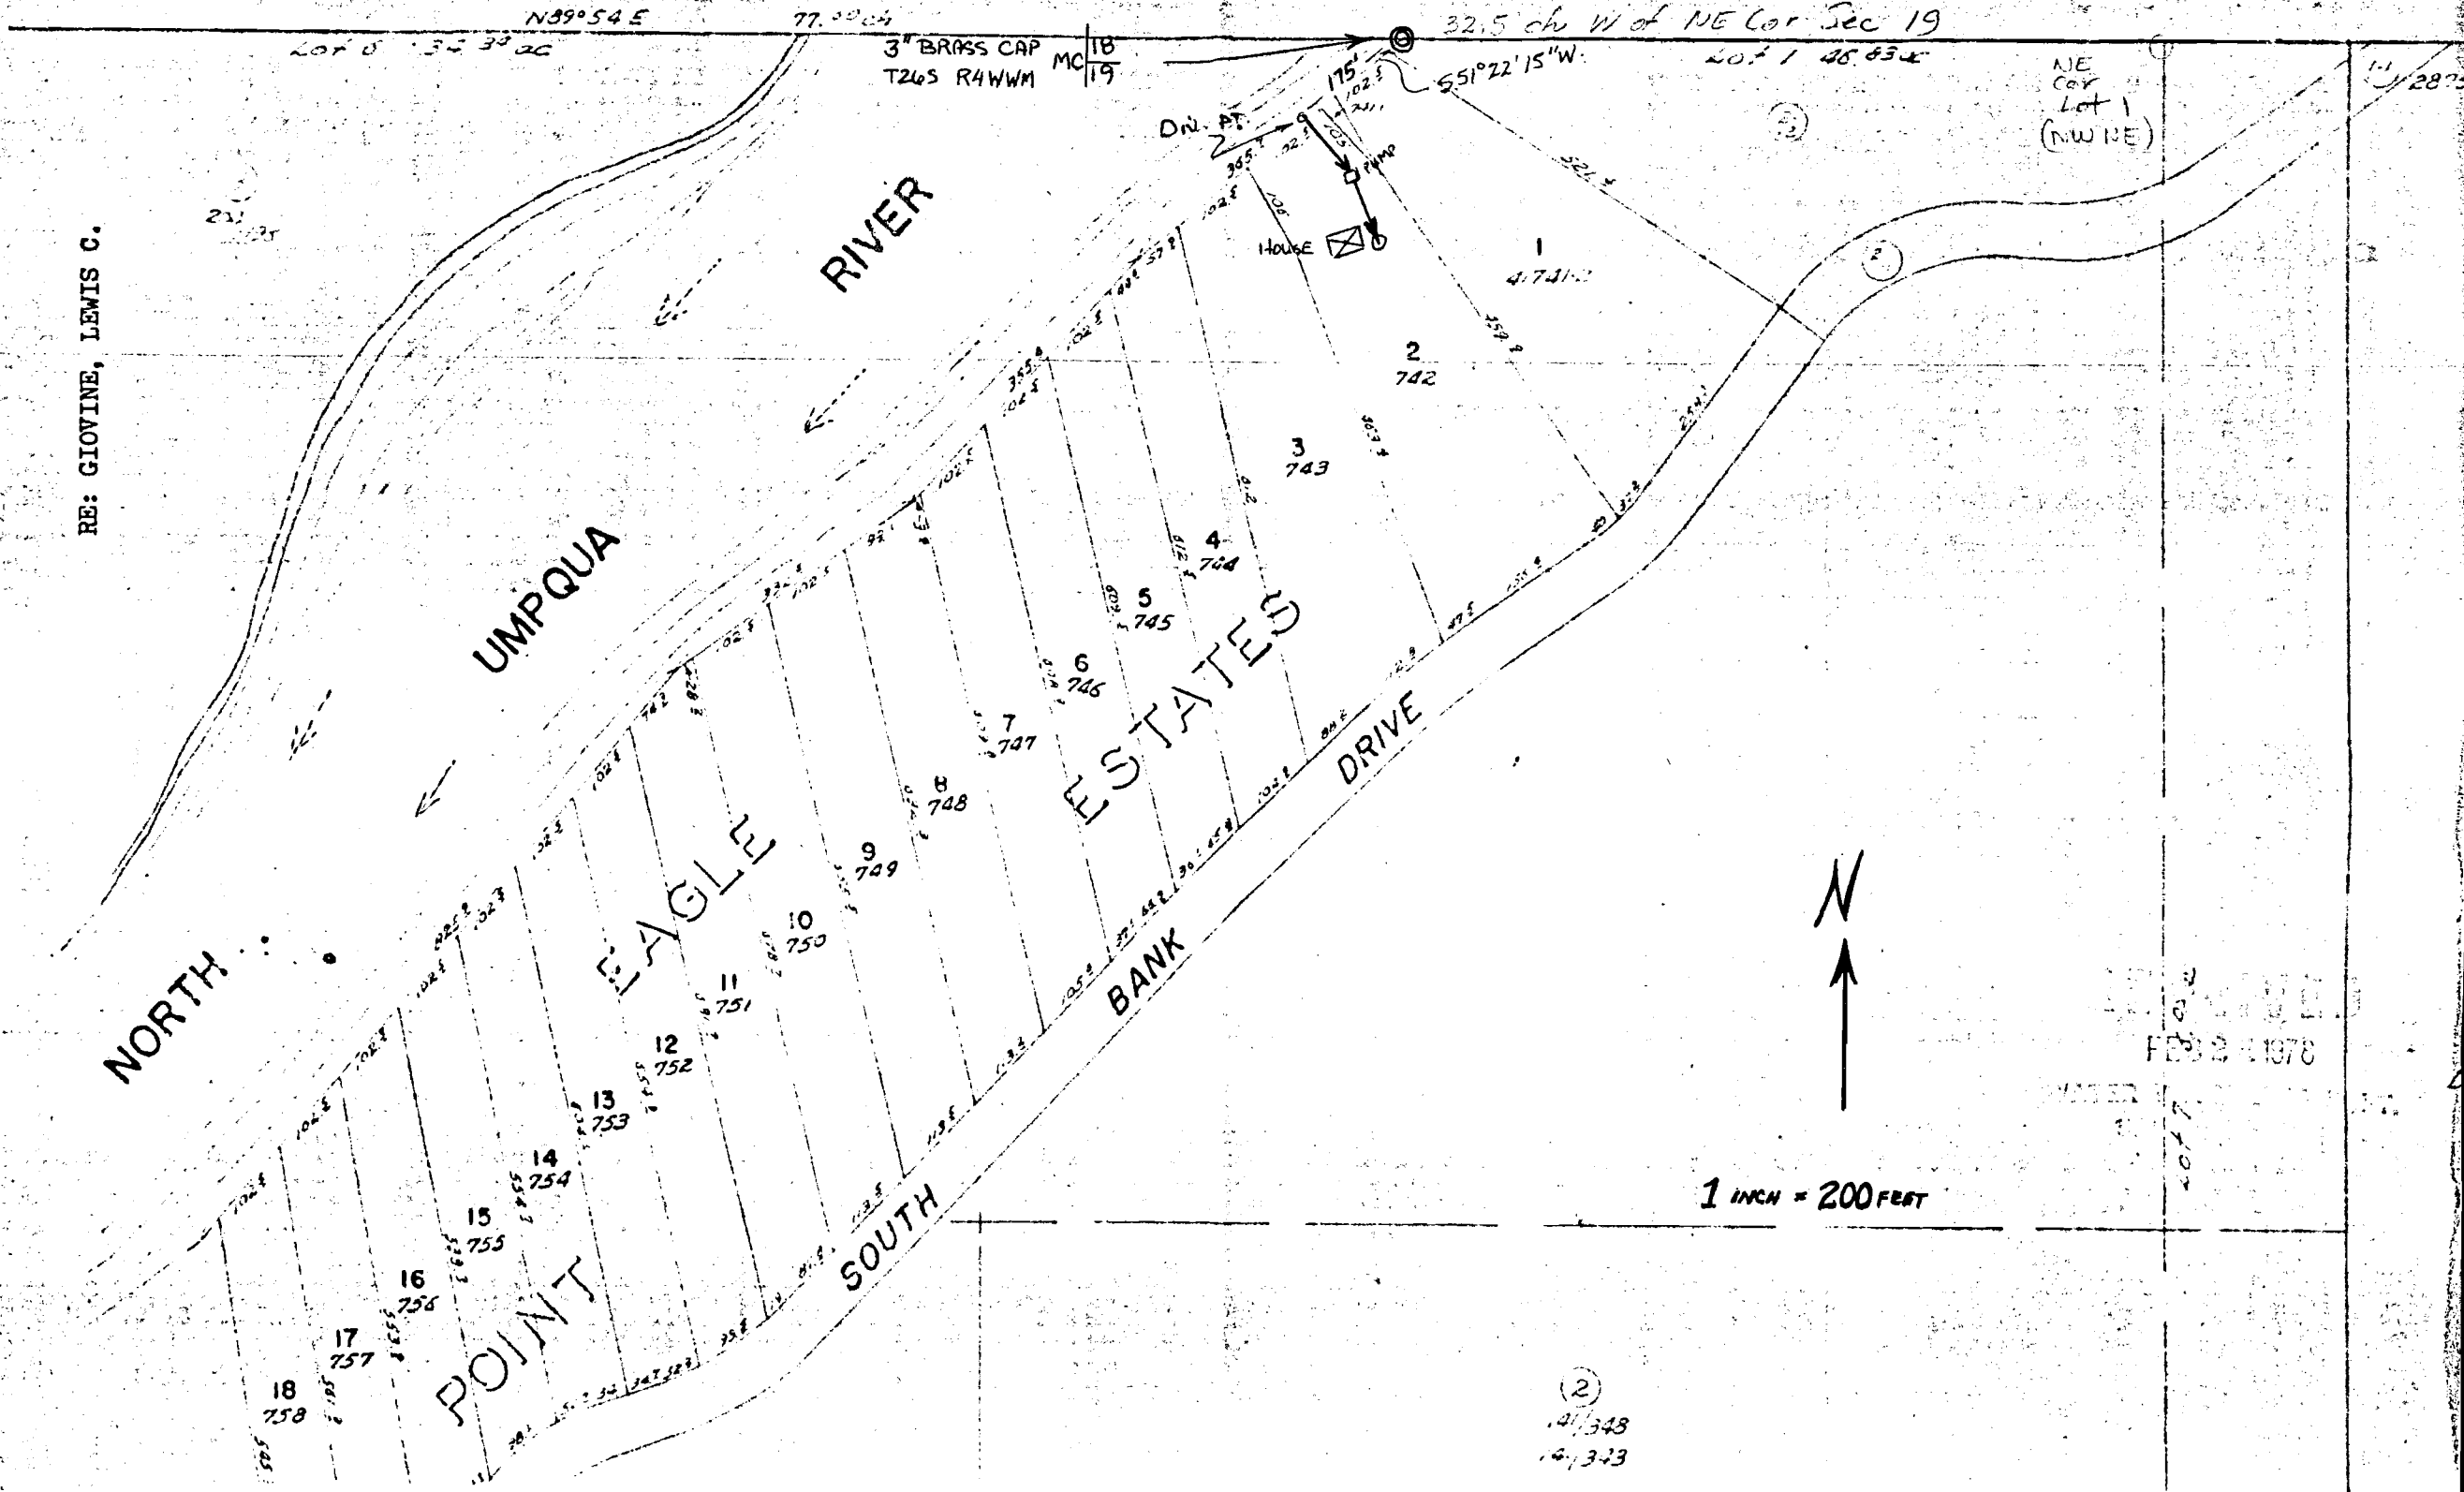

FEB 2 1978

(2)  
141,348  
141,343