

WATER

RIGHT

MAP

RECEIVED

RECEIVED

FOR: BOB KAUER JR.
RT. 3, BOX 546
CORNELIUS, OREGON

APR 25 1978

MAR 1 1977

WATER RESOURCES DEPT.
SALEM, OREGON


WATER RESOURCES DEPT.
SALEM, OREGON

TOWNSHIP 1 NORTH, RANGE 4 WEST, W. M.

SECTIONS 12 & 13

Application No. 55390, R55389

Permit No. 42988, R 9150

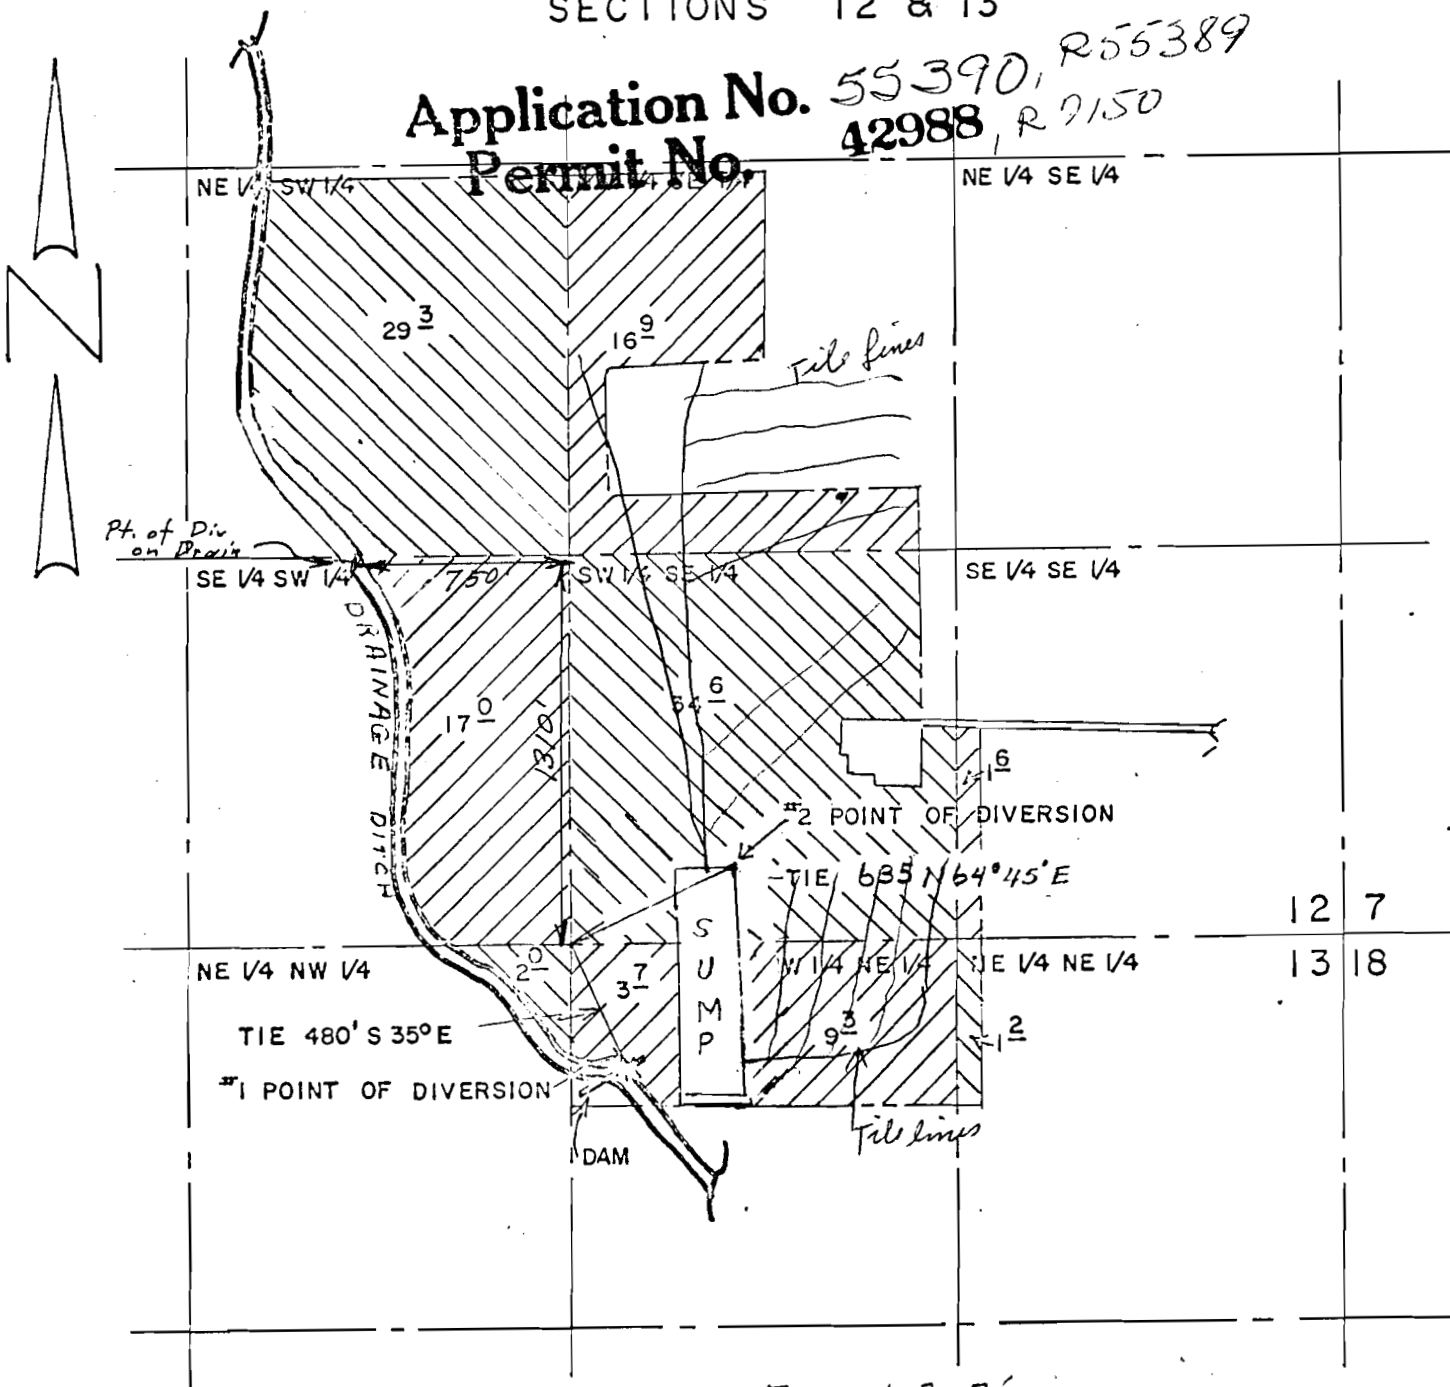

25 SULT - 1-7-76
EARR