


Application No. 57200  
Permit No. 42992

T. 5 & 6 S. R. 1 W. W. M.

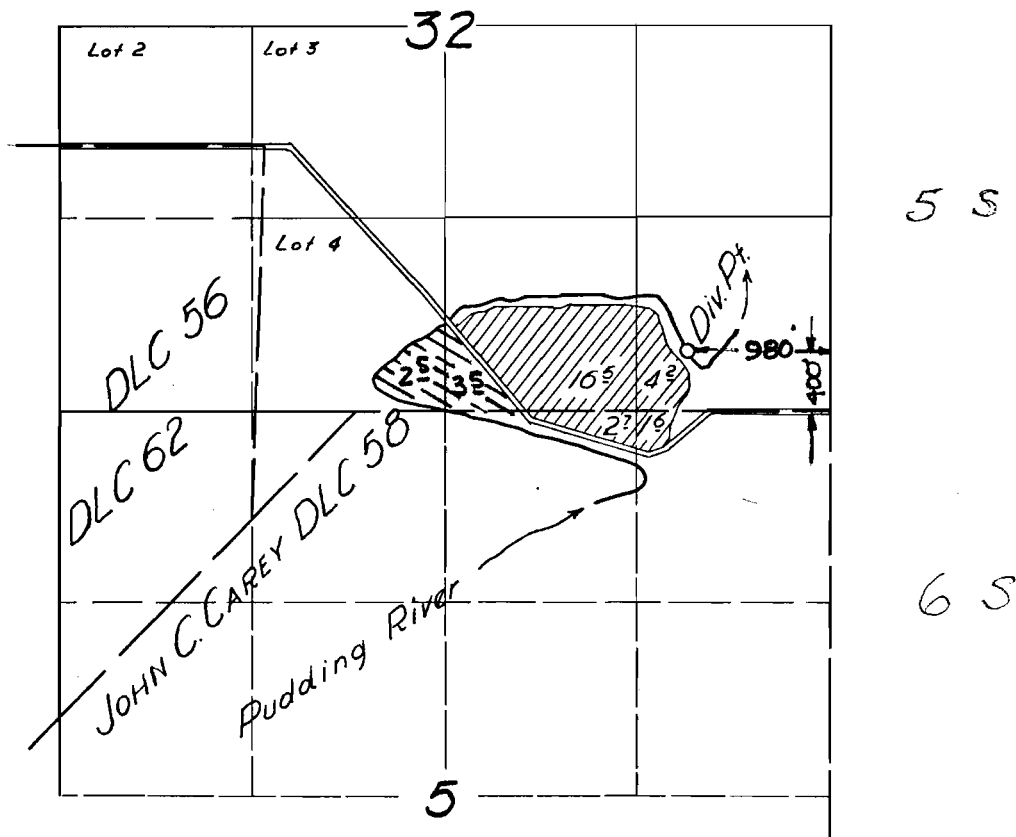

THIS MAP PREPARED BY

*U.S. Name*

**FINAL PROOF SURVEY**

UNDER

~~Application No. 19256 Permit No. 14835~~

IN NAME OF

~~JOHN FRANK~~

Surveyed 8 June 1950, by *[Signature]*