


# T. 39 S., R. 5 W., W. M.

RECEIVED

APR 1 1986

WM. DIST. 14  
GRANTS PASS, ORE.

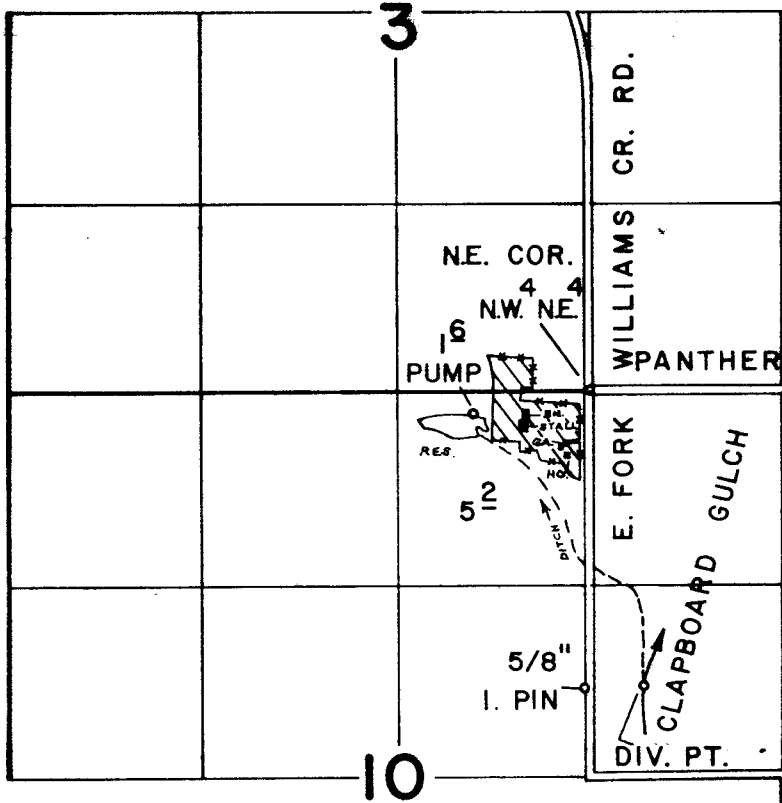

DIV. PT. LOC. - 2030 FT. S. & 350 FT. E., RES. - 150 FT.  
S. & 800 FT. W., BOTH FROM N.E. COR., N.W. 1/4 N.E. 1/4,  
SEC. 10.

## FINAL PROOF SURVEY UNDER

Application No. 57202 Permit No. 43012  
IN NAME OF

JOHN J. SPETTER

Surveyed NOV. 9 1978, by B. SUND

D.H.M.

P.T.S. - 1978 - 14 - D

P.T.S. - 1979 - 14 - A

P.T.S. - 1961 - V