


Application No. 57031, R 57031  
 Permit No. 43053, R 7254  
 T. 40S. R. 2W. W. M.

SLICKTAW DITCH DIV. IS LOCATED 840' N. AND 1530' E. FROM THE W. 1/4 COR. OF SEC. 6, BEING WITHIN THE SW 1/4 NW 1/4 SEC. 6, T. 41S. R. 2W. W. M.

RES. #2 IS LOCATED 650' N. AND 1700' E. FROM THE W. 1/4 COR. OF SEC. 6, BEING WITHIN THE SW 1/4 NW 1/4 (GOV'T. LOT 5) OF SEC. 6 T. 41S. R. 2W. W. M.

HASKIN DITCH DIV. IS LOCATED 283' N. AND 1154' W. FROM THE SE COR. OF SEC. 31, T. 40S. R. 2W. W. M. BEING WITHIN THE SE 1/4 SE 1/4 OF SEC. 31.

RES. #1 IS LOCATED 800' S. AND 210' E. FROM THE W. 1/4 COR. OF SEC. 6 BEING WITHIN THE NW 1/4 SW 1/4 (GOV'T. LOT 6) OF SEC. 6, T. 41S. R. 2W. W. M.

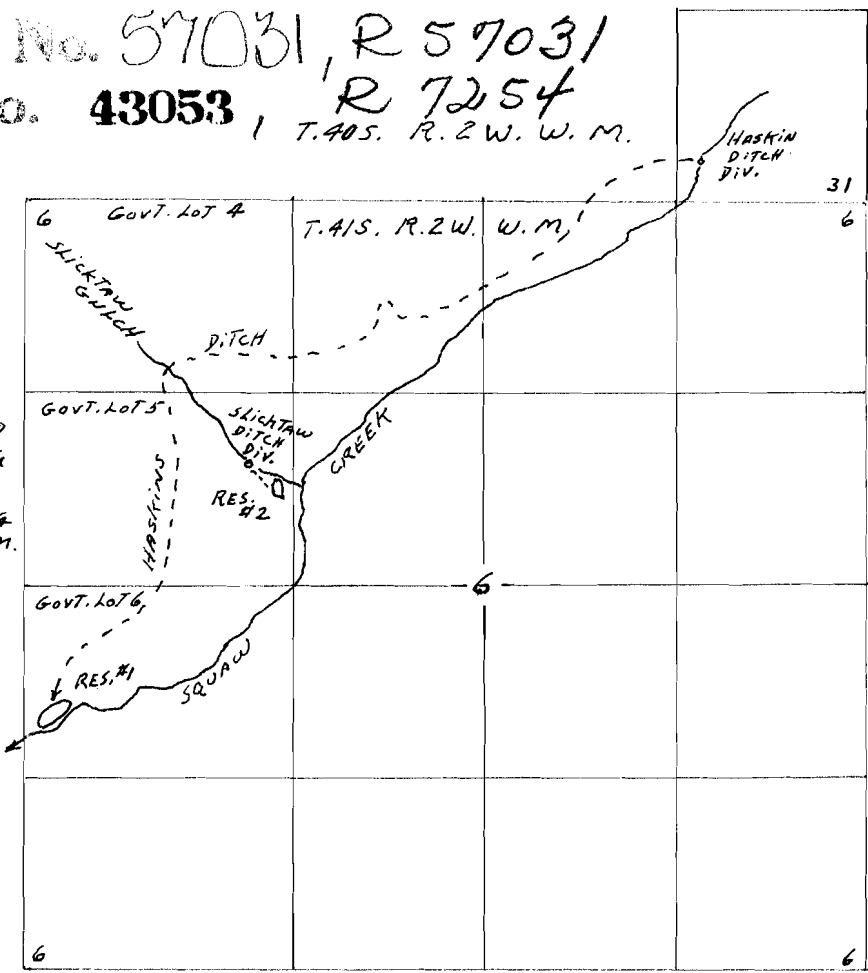

MAP TO ACCOMPANY APPLICATION OF A.C. PIERCE FOR FISH CULTURE IN HASKIN AND SLICKTAW DITCHES AND RESERVOIRS #1 AND #2

THIS MAP DRAWN BY:  
*A.C. Pierce*  
 PROJECT ENGINEER

SCALE 4" = 1 MILE

