


T. 35 S., R. 7 W., W.M.

43109
R-7349
35-7-23

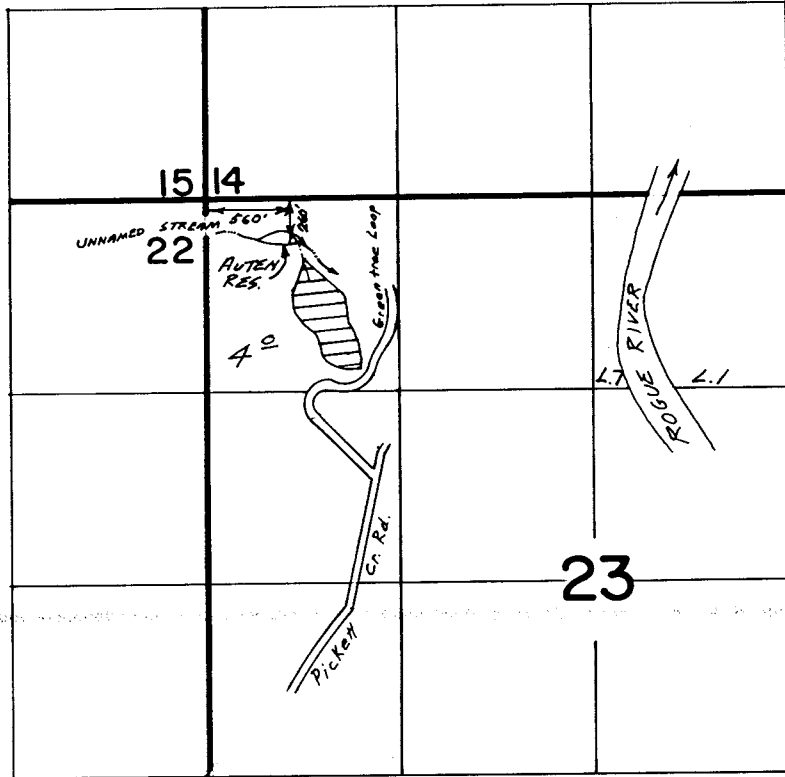

Scale : 1" = 1320'

FINAL PROOF SURVEY
UNDER

R-57128 R-7349
Application No. 57129 Permit No. 43109.....
IN NAME OF

Peter C. Sedlow and Lindi L. Leger.....

Surveyed Nov. 3, 1987, by B.S. JAMES.....