


Permit: S 43114  
Volume: 5B  
Strm: HUGHES G  
Trib: WOLF CR  
Priority: 4/10/78

# T. 33S., R. 7W., W. M.

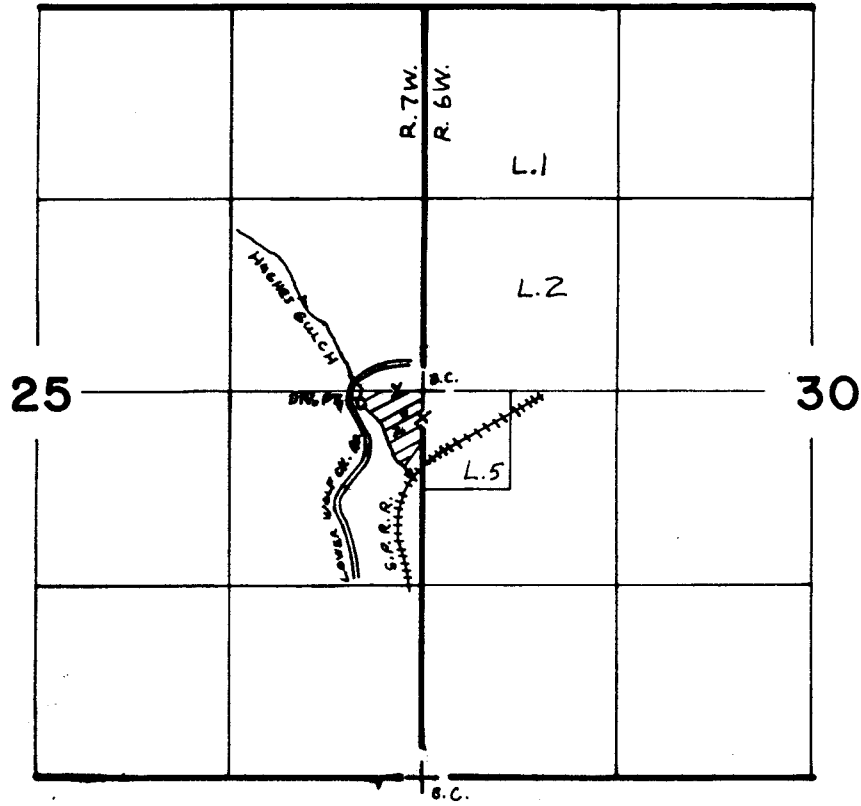

DIV. PT.: 90'S. & 420'W. FROM E, 1/4 COR. SEC. 25

SCALE: 1"=1320'

## FINAL PROOF SURVEY UNDER

Application No. 57276... Permit No. 43114.....  
IN NAME OF

VERA JEAN & CORINNE E. STUMBO

Surveyed SEPT. 6 1984, by J. WOODROOF

APR 5 1989

41033-179-160R JRM