


T385 R14W

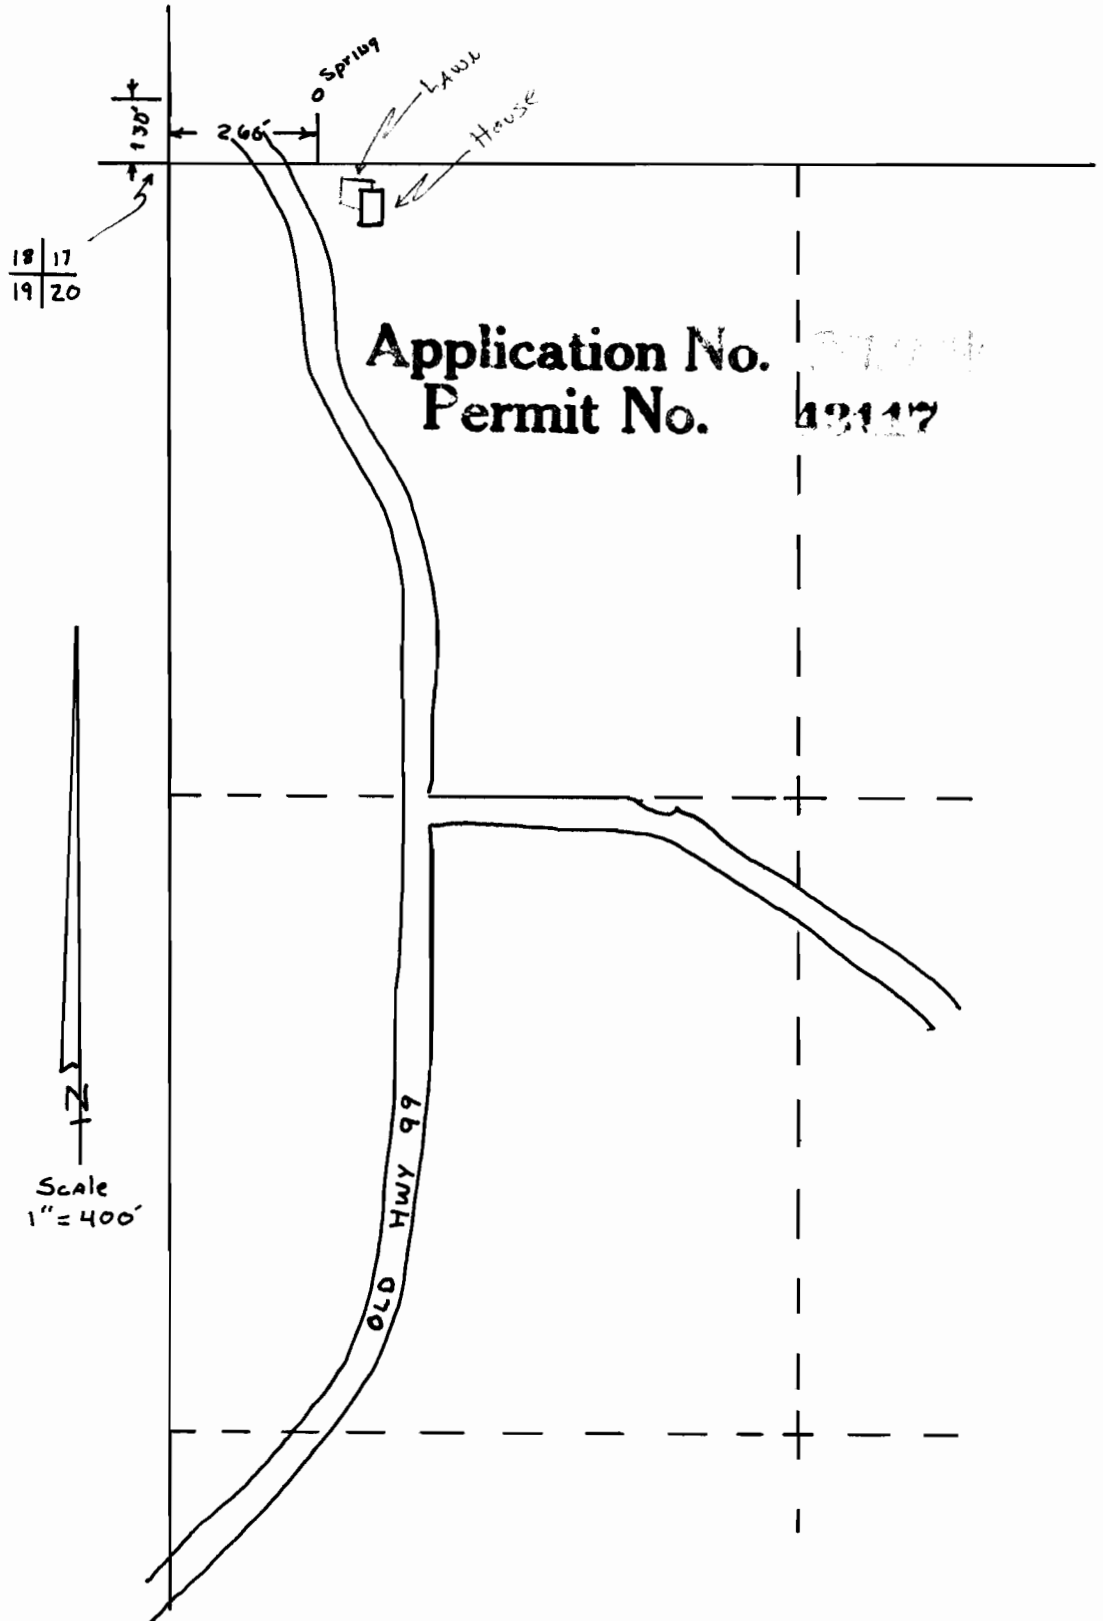

THIS MAP PREPARED BY: J. P. Drolet, N. Bend Field Office
FROM INFORMATION FURNISHED BY THE
APPLICANT.