


T23S R12W  
Sec 29

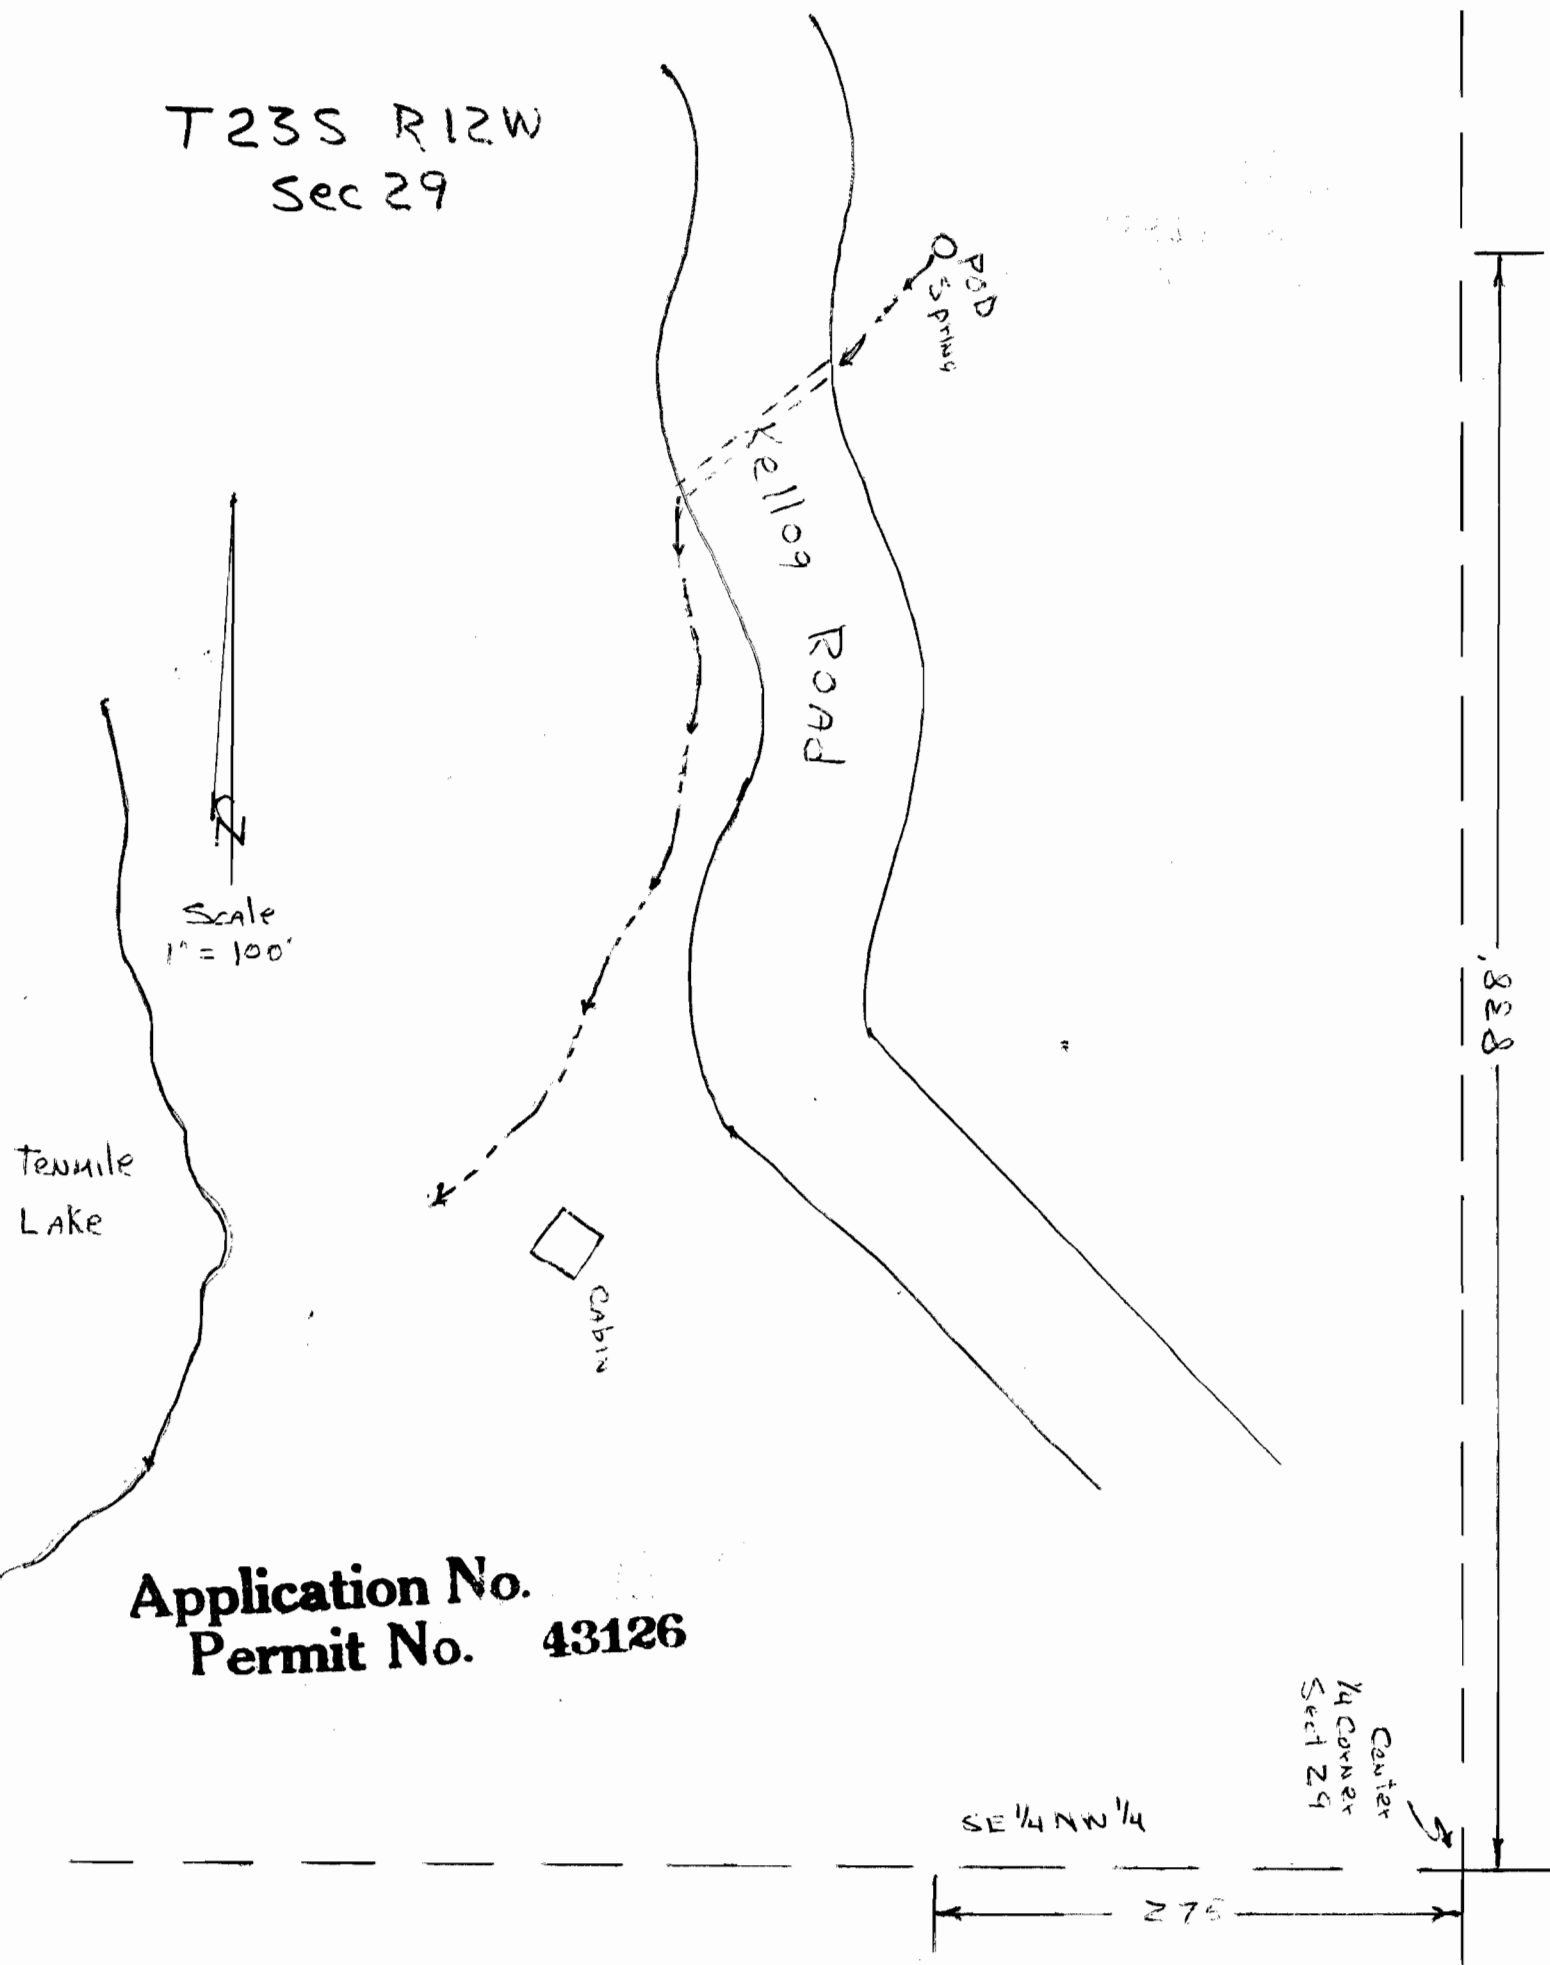

Application No.  
Permit No. 43126

SE  $\frac{1}{4}$  NW  $\frac{1}{4}$

275

Center  
 $\frac{1}{4}$  Corner  
Sect 29

838'