
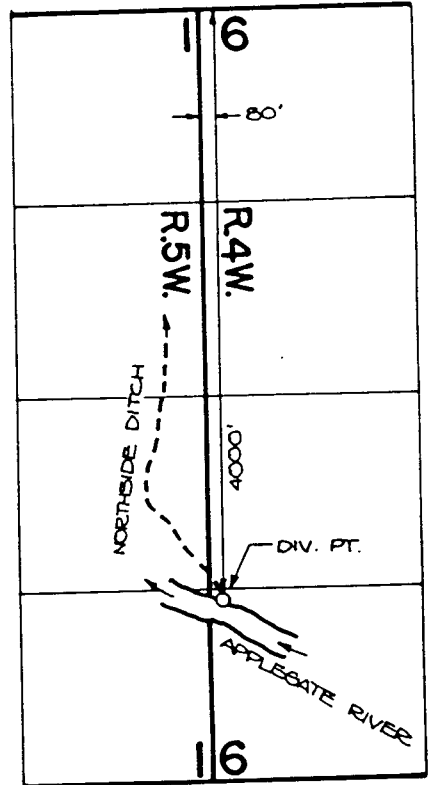


43155

T.37S., R.5W., W.M.

T.38S., R.485W., W.M.

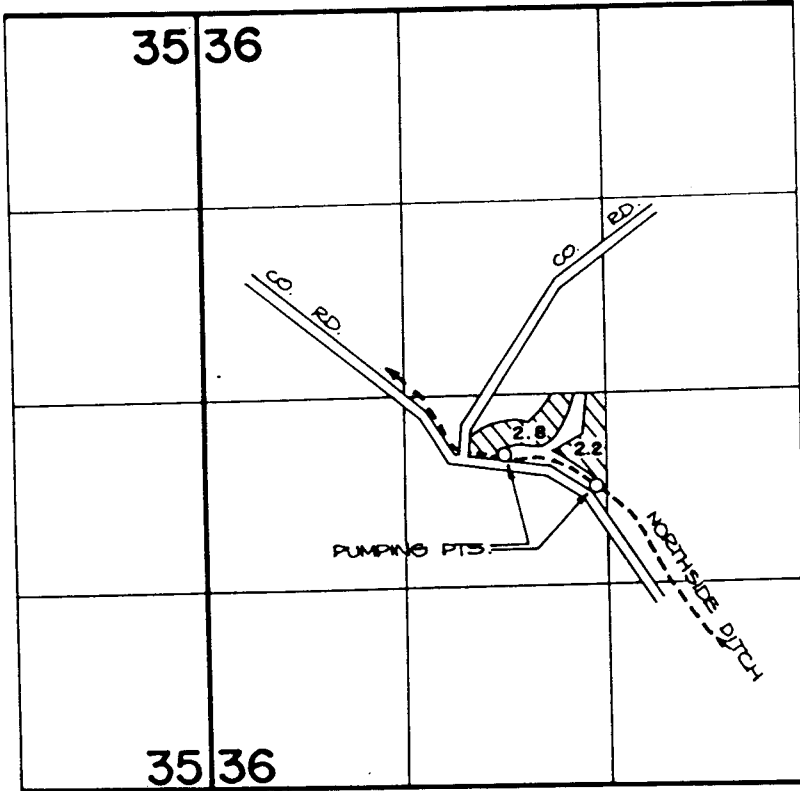

RECEIVED

SEP 29 1989

PL 14  
CIVIL ENG. DIV.

**FINAL PROOF SURVEY**  
UNDER

Application No. **57337** Permit No. **43155**  
IN NAME OF

**JAMES G. BEGG**

Surveyed **AUG. 16, 1983**, by **B. JAMES**