


# T. 36 S., R. 6 W., W.M.

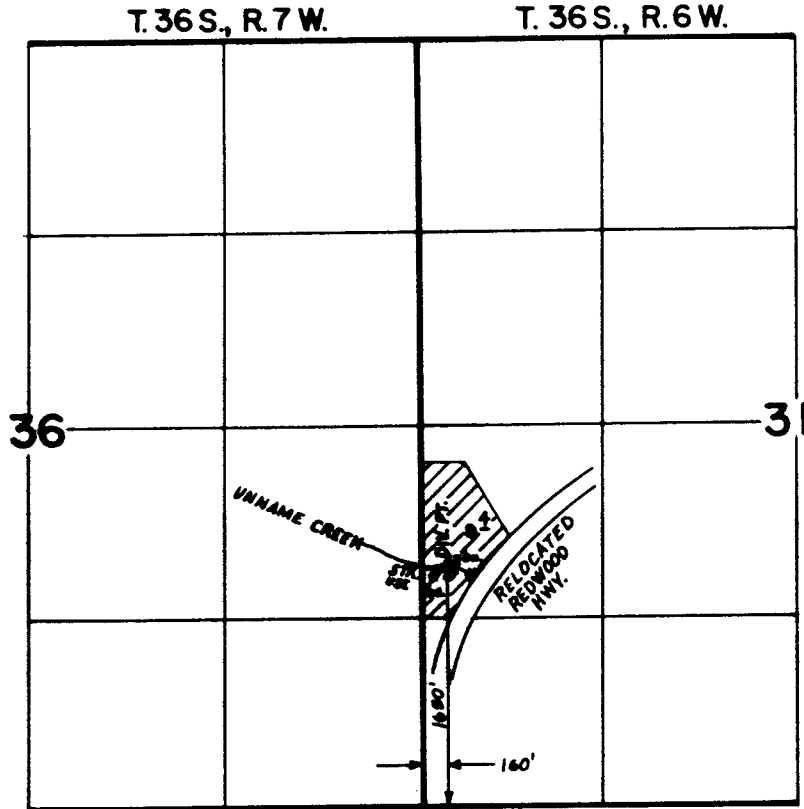

Scale: 4" = 1 mile

MAY 7 1989

## FINAL PROOF SURVEY UNDER

Application No. 57355 Permit No. 43184  
IN NAME OF

ROBERT L. SHELBY

Surveyed JAN. 19. 1984, by B. S. JAMES