


RECEIVED

APR 25 1978

WATER RESOURCES DEPT.
SALEM, OREGON

Application No. 57340
Permit No.

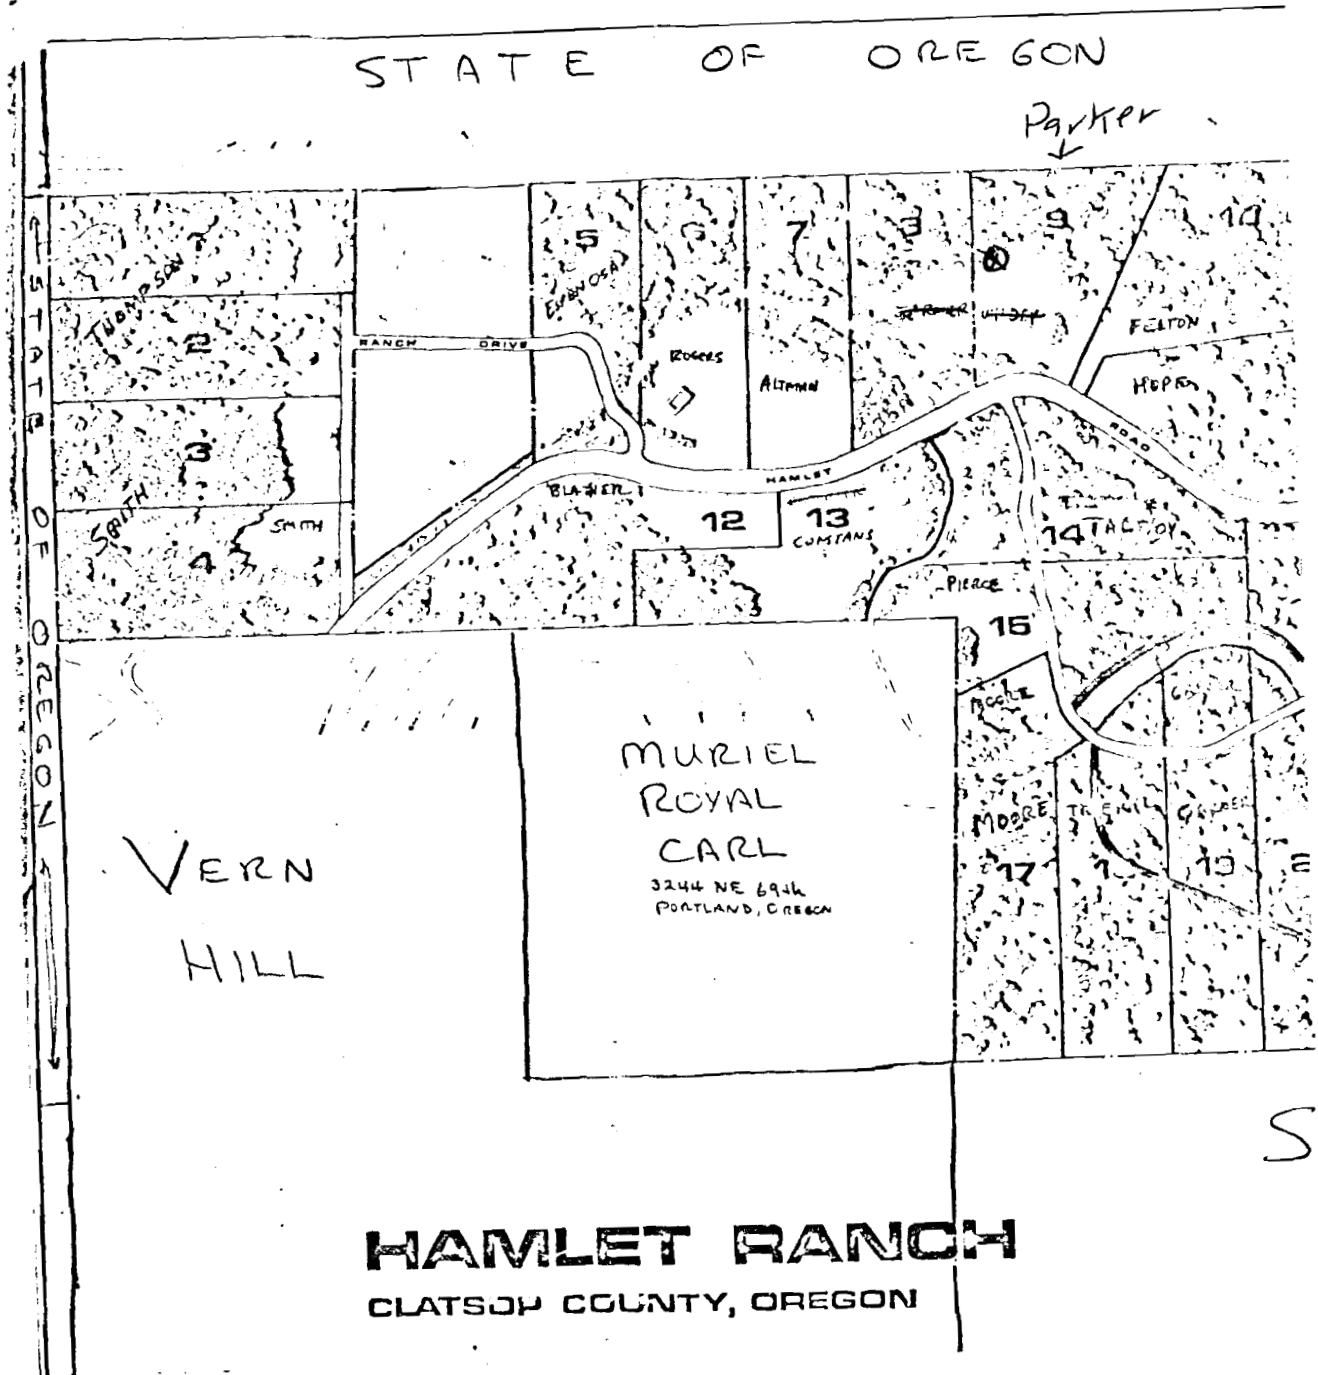


RECEIVED

APR 25 1978

RECEIVED

JUL 19 1978

WATER RESOURCES DEPT. WATER RESOURCES DEPT.
SALEM, OREGON SALEM, OREGON

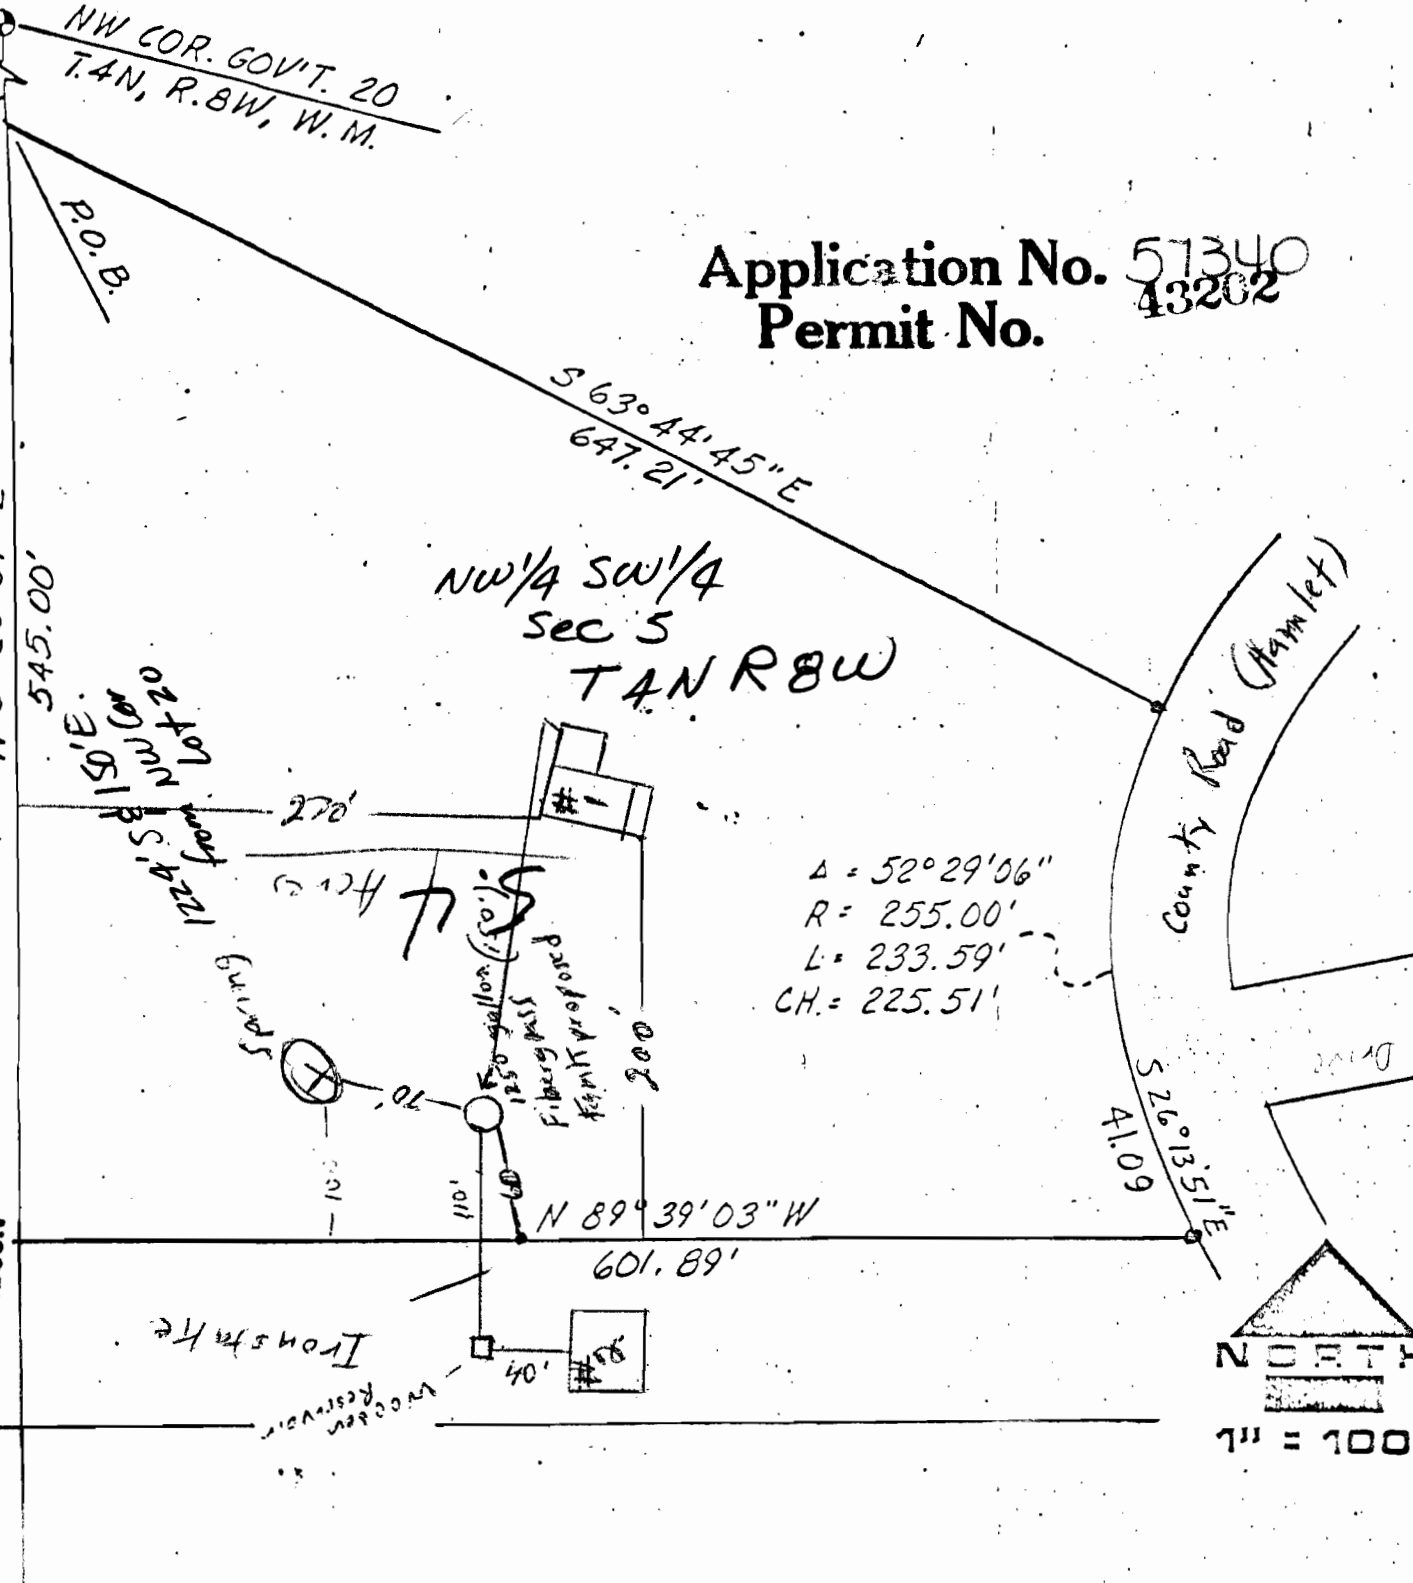

Note:

① My house is house #1, House #2 is neighbor.

② Work is complete now except for line & pump to House #1

HAMLET RANCH
RANCHETTE NO. 9

DELTA ENGINEERING
P.O. BOX 520 - SUMNER, WA. 98390
TACOMA UN3-4484 - SEATTLE YEB-9210