


BASED ON M-58-29

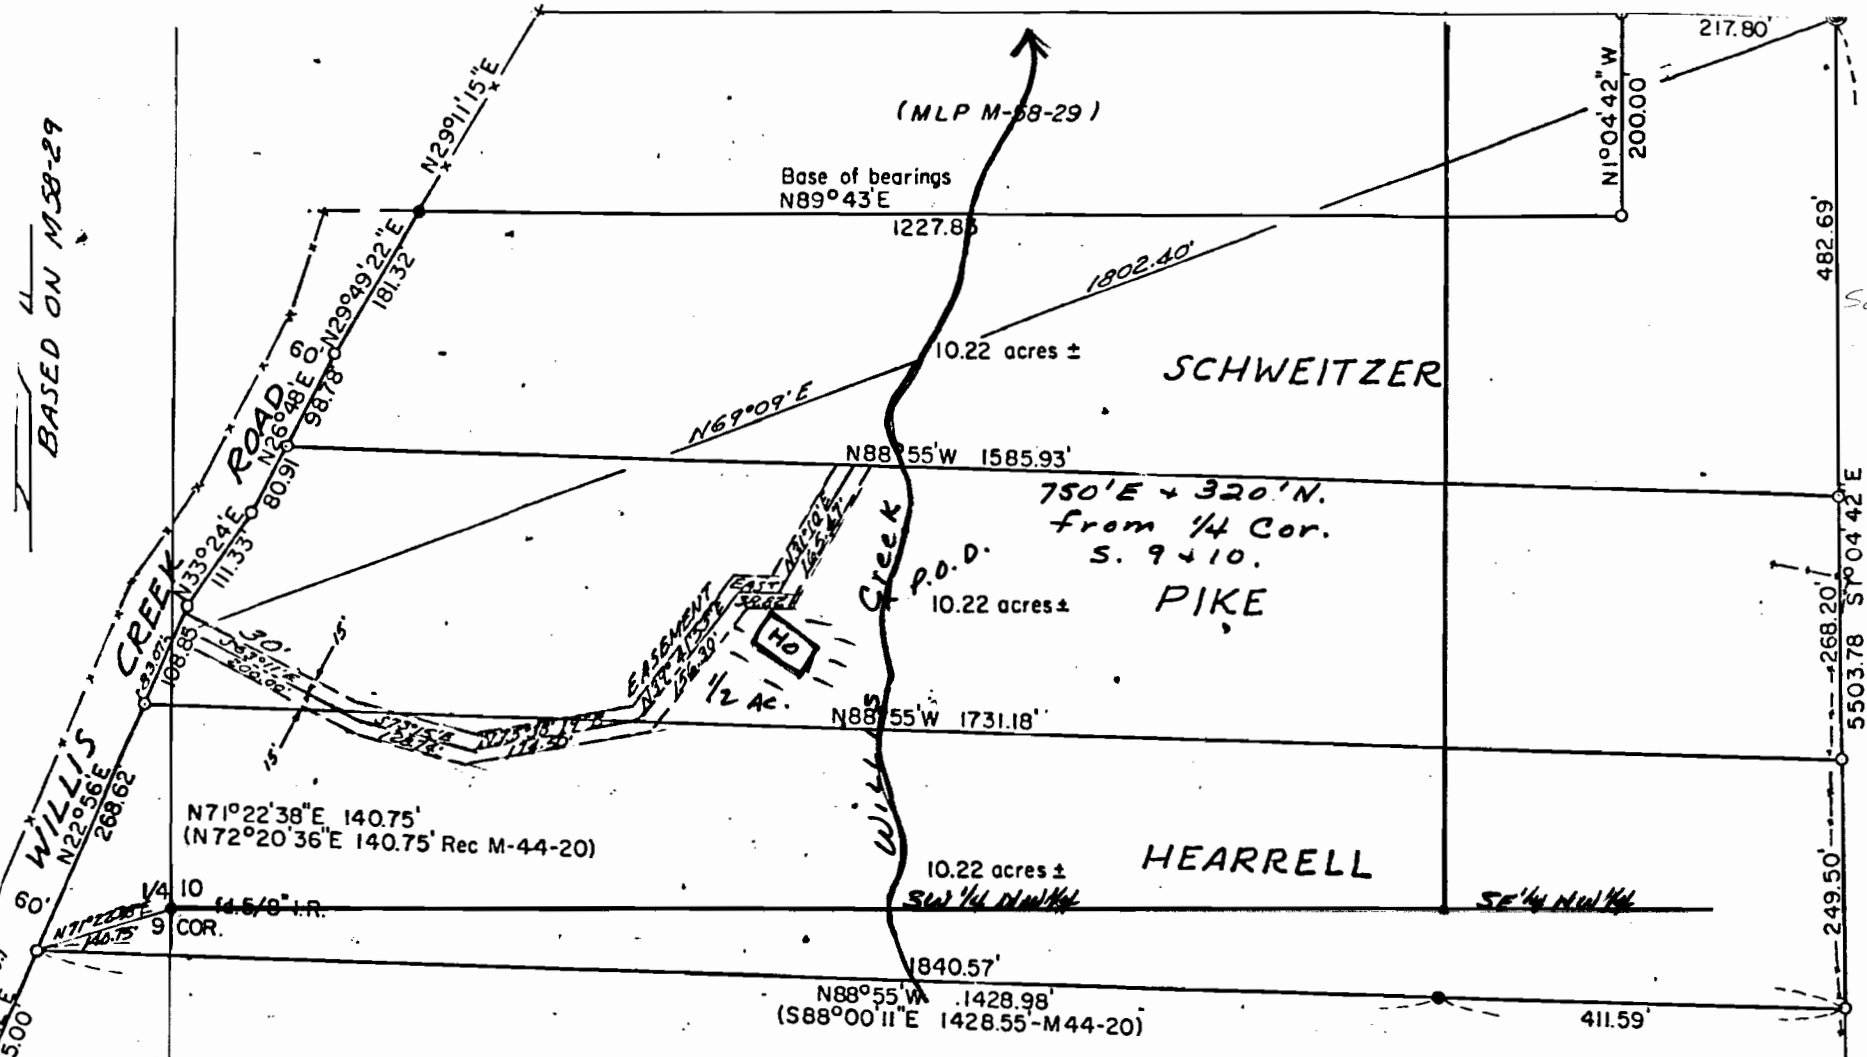

Sec. 10

RECEIVED
 JUL 13 1978
 WATER RESOURCES DEPT.
 SALEM, OREGON.

T. 29S. R. 6W. S. 10

1" = 200'

Application No. 57640
Permit No. 43432

S.E. Cor. DL