


Application No. 57600
Permit No. 43227

T.23S.R.8W.W.M.

RECEIVED
JUL 10 1978
WATER RESOURCES DEPT.
SALEM, OREGON

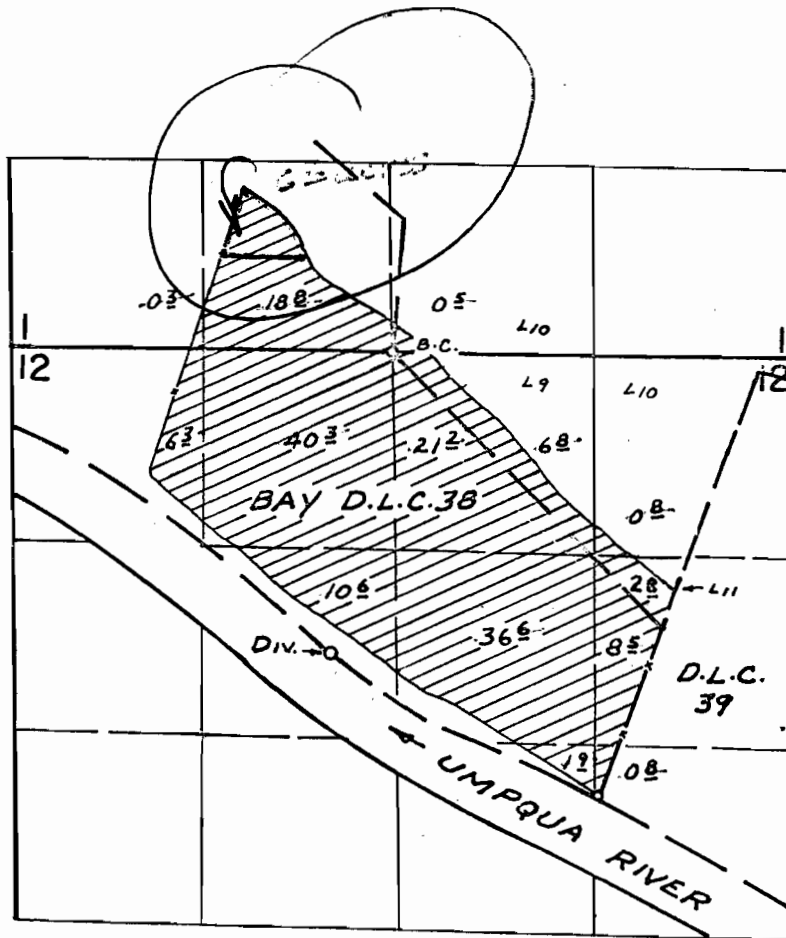

DIV. LOC: 2080' S. & 450' W. FROM N 1/4 COR. SEC. 12

50 ft

~~FINAL PROOF SURVEY~~
UNDER

~~Application No. 44609 Permit No. 33424~~
IN NAME OF

~~CHARLES A. & VIRGIL K. KESTERSON~~

~~Surveyed MAY 13 1976, by R. MUCKEN~~

RECEIVED
OCT 8 1990
WATER MASTER
DISTRICT 13