


T. 36S., R. 7W., W. M.

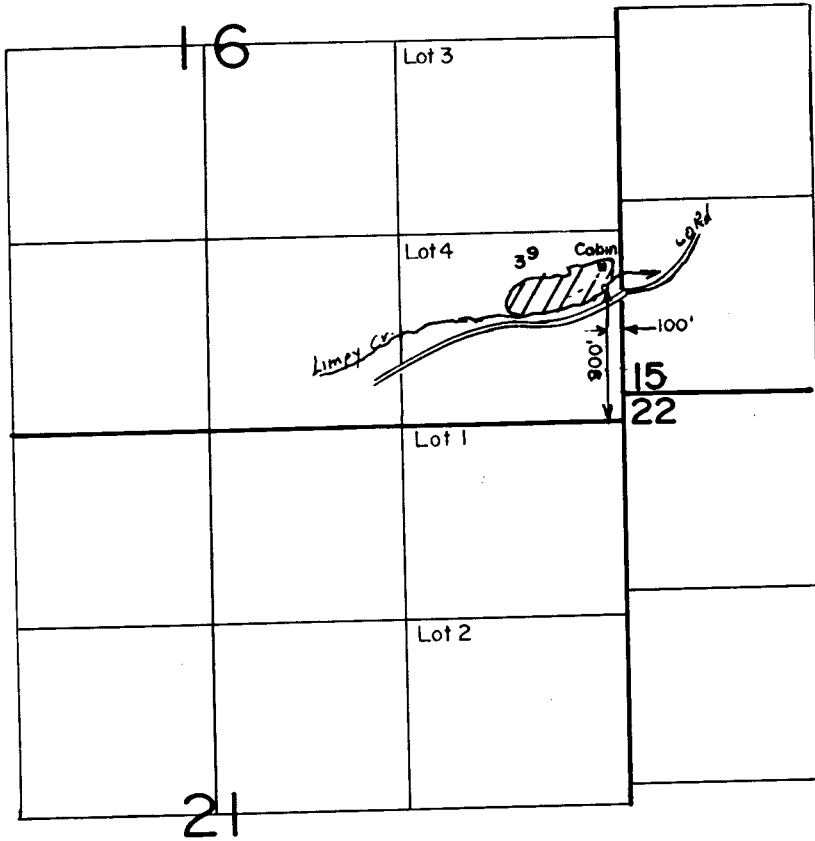

SCALE: 1"=1320'

FINAL PROOF SURVEY
UNDER

Application No. 57432.. Permit No. 43267.....
IN NAME OF

.....**Louise**.....**LaBarbara**.....

Surveyed **MAY 25**... **1989**., by **B.S. JAMES**.....

RECEIVED
APR 24 1991
WM. DIST. 14
GRANTS PASS, ORE.