FEB 27 1987
W.M. DIST. 14
GRANTS PASS, ORE.

T.37 & 38 S., R.5W., W.M.

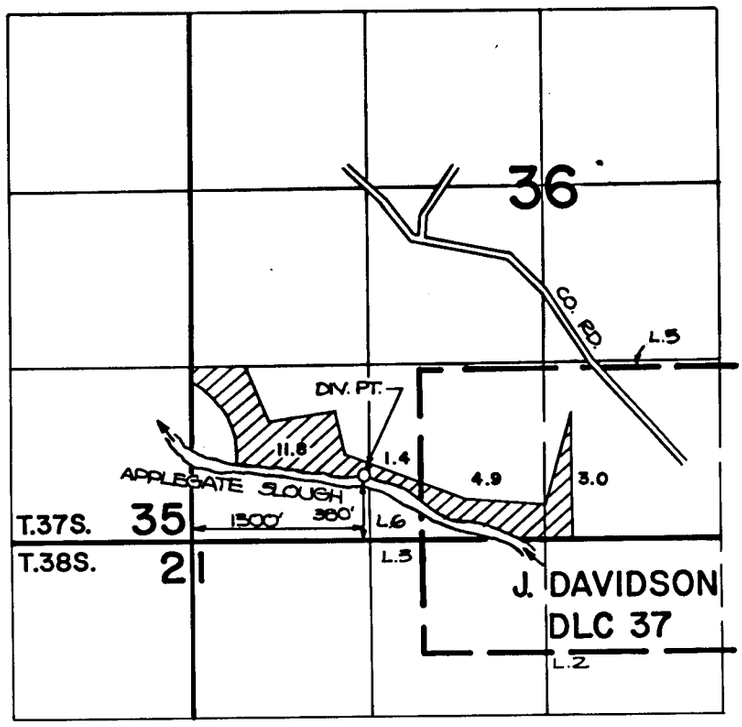

FINAL PROOF SURVEY

UNDER

Application No. 62209 / 57447 Permit No. 46080 / 43268

IN NAME OF

JERRY NOBLE

Surveyed APR 29, 1982, by B. SUND

41053-179-110R PRP 2/7/84