


T.35S., R.7W., W.M.

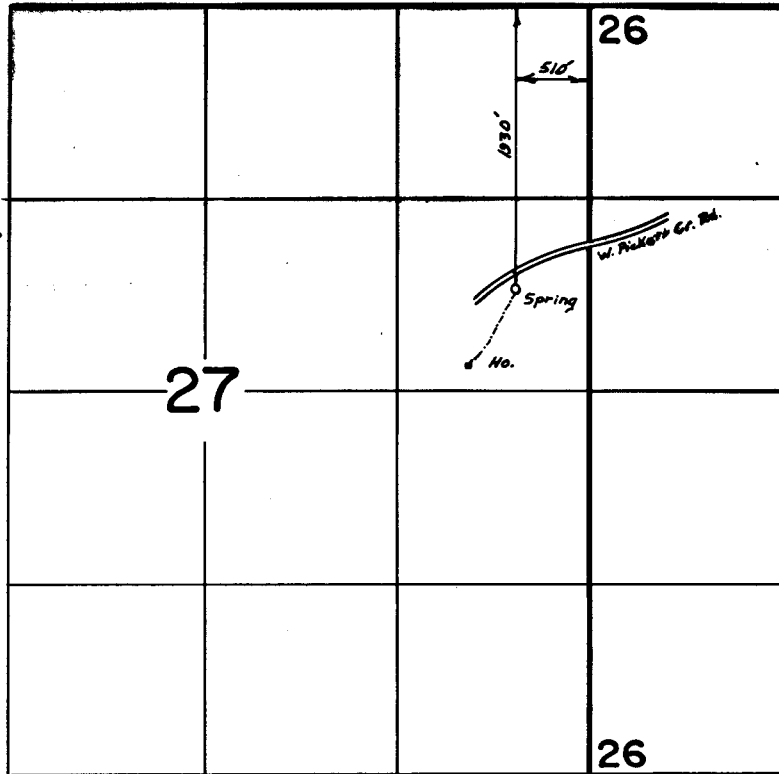

Scale 1"=1320'

FEB 12 1988

MIN. DIST. 1/4
QUARTER PERIOD 1988

FINAL PROOF SURVEY
UNDER

Application No. 57413.. Permit No. 43272.....
IN NAME OF

.....TIMM.....ANDERSEN.....

Surveyed Oct. 27.. 1985., by B.S. JAMES.....