


Application No. 57430
Permit No. 43279

T 26 S. R 4 W.

RECORDED
MAY 13 1978

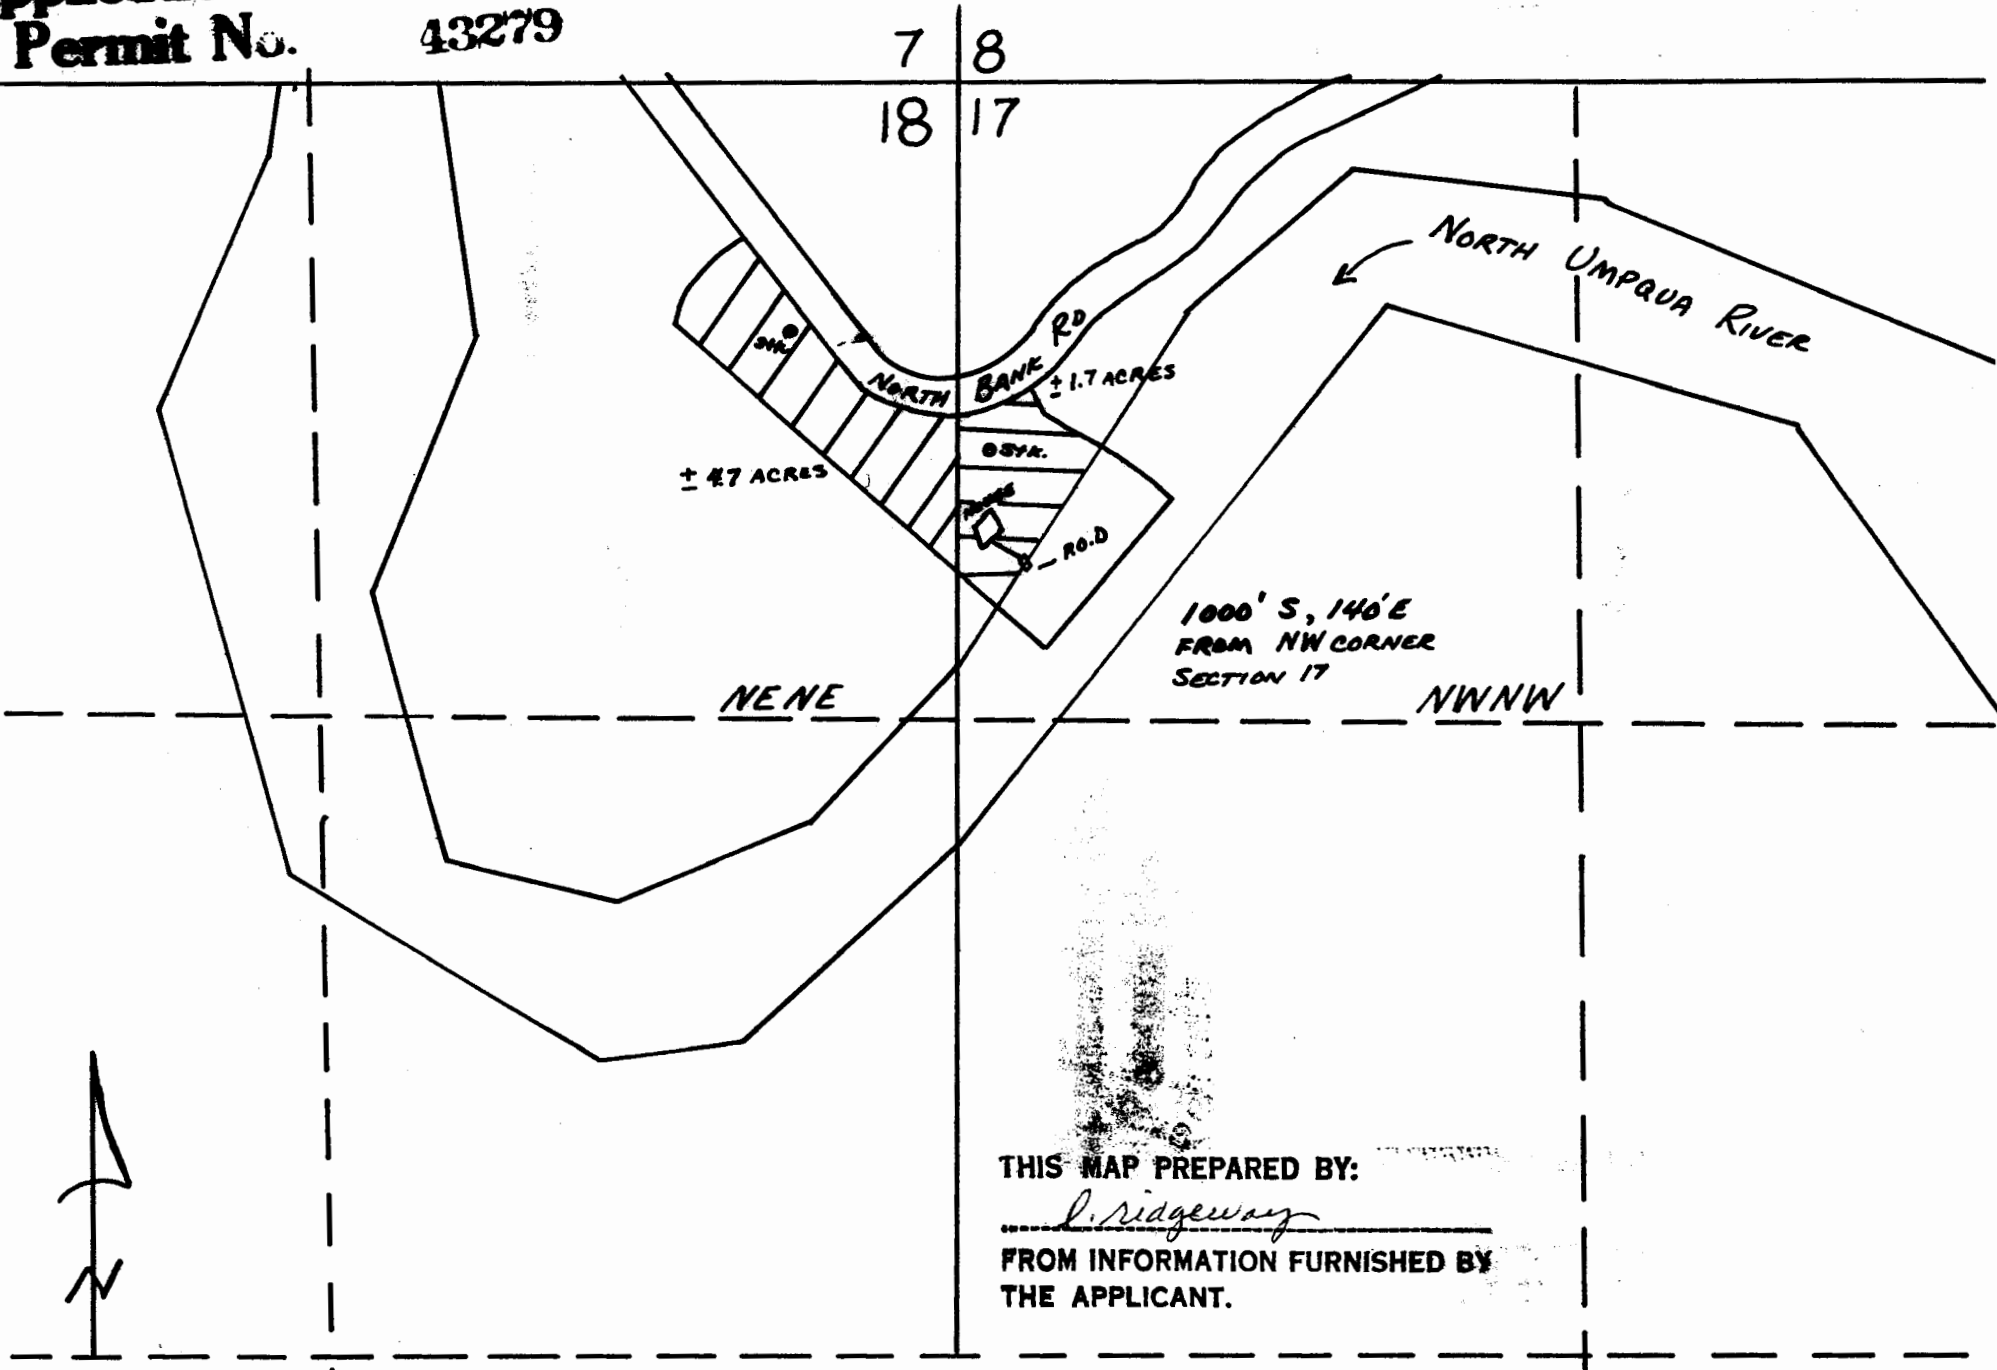

THIS MAP PREPARED BY:
L. Ridgeway
FROM INFORMATION FURNISHED BY
THE APPLICANT.

1" = 400'