


T. 40 S., R. 8 W., W.M.

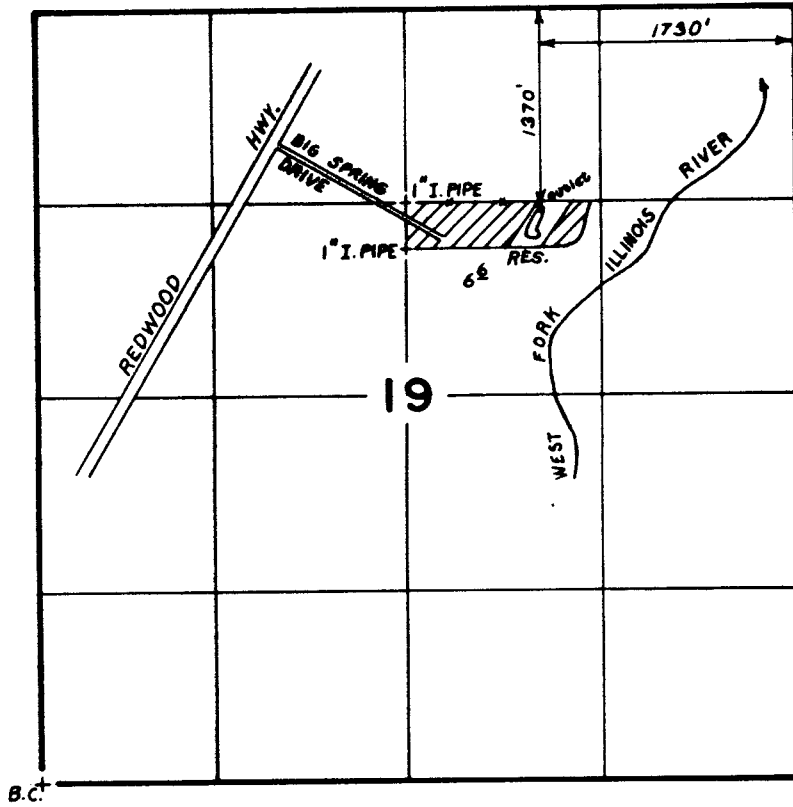

Scale: 4" = 1 MILE

MAR 03 1989

W.M. DIST. 14
COURTESY PAGES OFF.

FINAL PROOF SURVEY
UNDER

R-57348 R-7682
Application No. **57349** Permit No. **43340**
IN NAME OF

.....**CLIFFORD T. GATES**.....

Surveyed **March 26 1984**, by **B. S. JAMES**.....