


T. 36 S., R. 5 W., W.M.

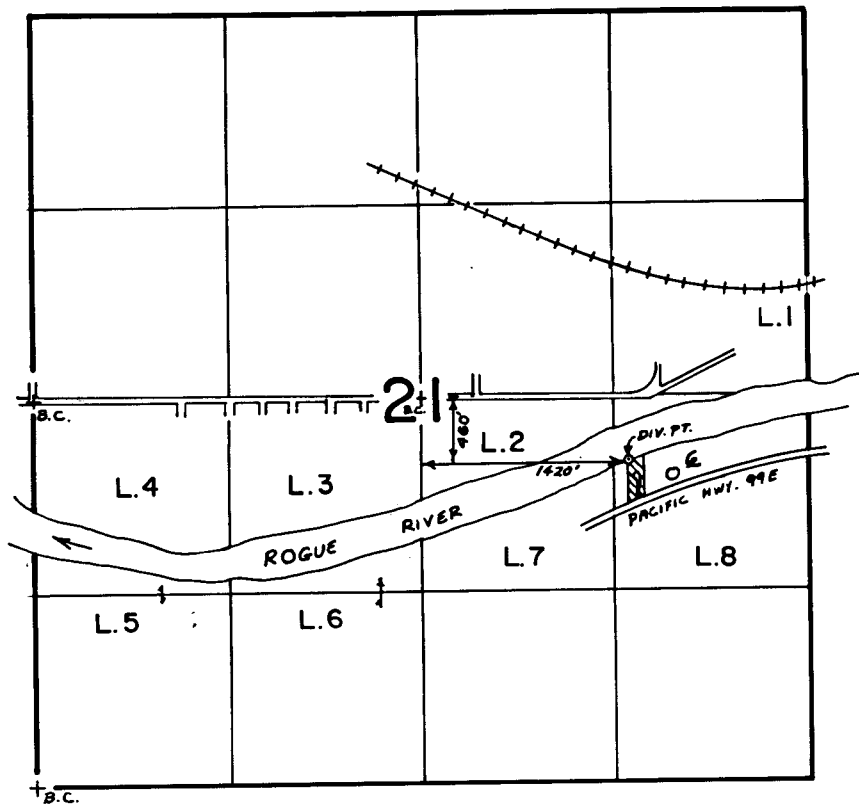

Scale : 4" = 1 mile

RECEIVED

APR 1 1987

VAL. DIST. 14
CRATED PERS. ONE

FINAL PROOF SURVEY
UNDER

Application No. 57516.. Permit No. 43345....
IN NAME OF

.....HARRY.....G.....McABEE.....

Surveyed Oct...30, 1981., by Bruce...R...Sund

B50-5-8 BSJ