


T.40S., R.8W., W.M.

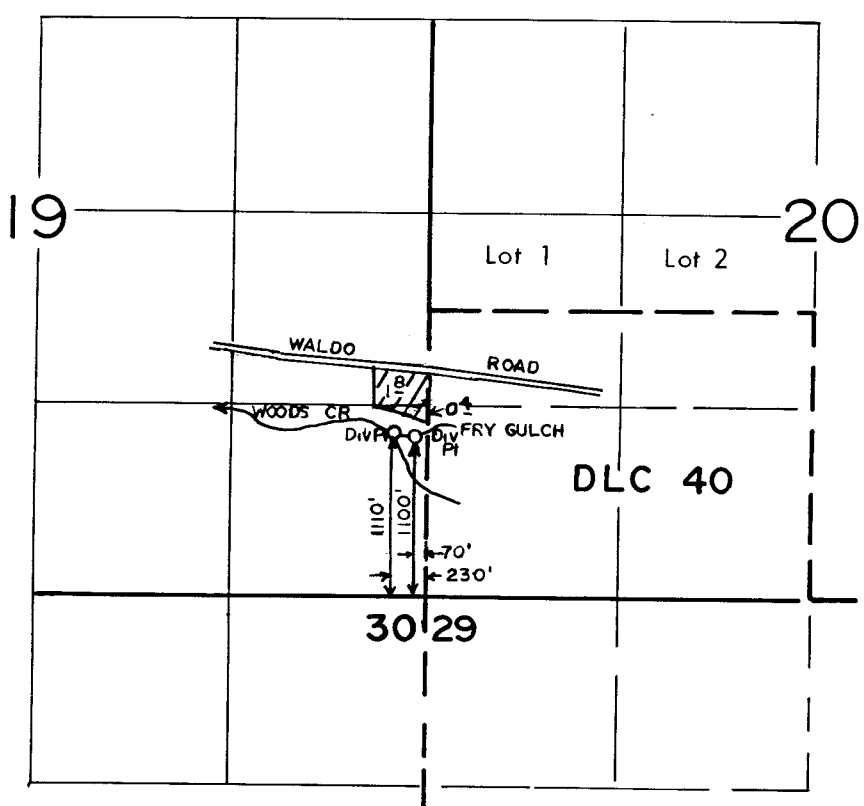

SCALE: 1" = 1320'

FINAL PROOF SURVEY UNDER

Application No. 575.86.... Permit No. 43354.....
IN NAME OF

.....TERRY..... &..... MARY..... WELCH.....

Surveyed MAR...26... 19.84., by B.S. JAMES.....

RECEIVED

JUL 31 1992

WM. DIST. 14
GRANTS PASS, ORE.