


Application No. 57544  
Permit No. 43361

T.29S. R. 4W. W.M.

**RECEIVED**

JUN 20 1978

WATER RESOURCES DEPT.  
SALEM, OREGON

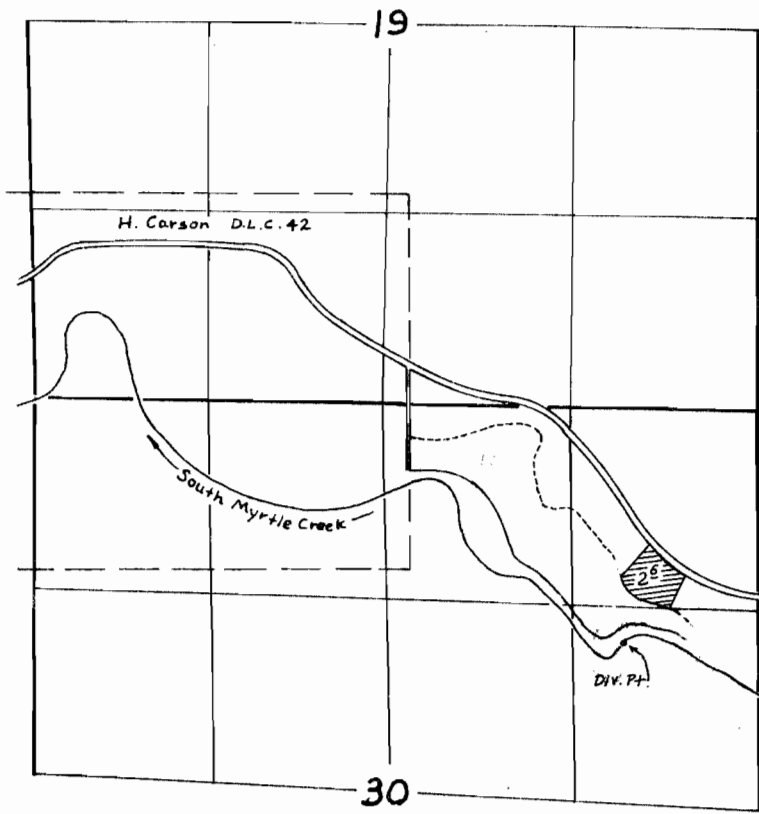

POD: 1,190' N, 900' W. from E $\frac{1}{4}$  cor. Sec. 30  
being within the SE $\frac{1}{4}$  NE $\frac{1}{4}$  of Sec. 30,  
T.29S., R.4W.W.M.