


T. 36 S., R. 6 W., W.M.

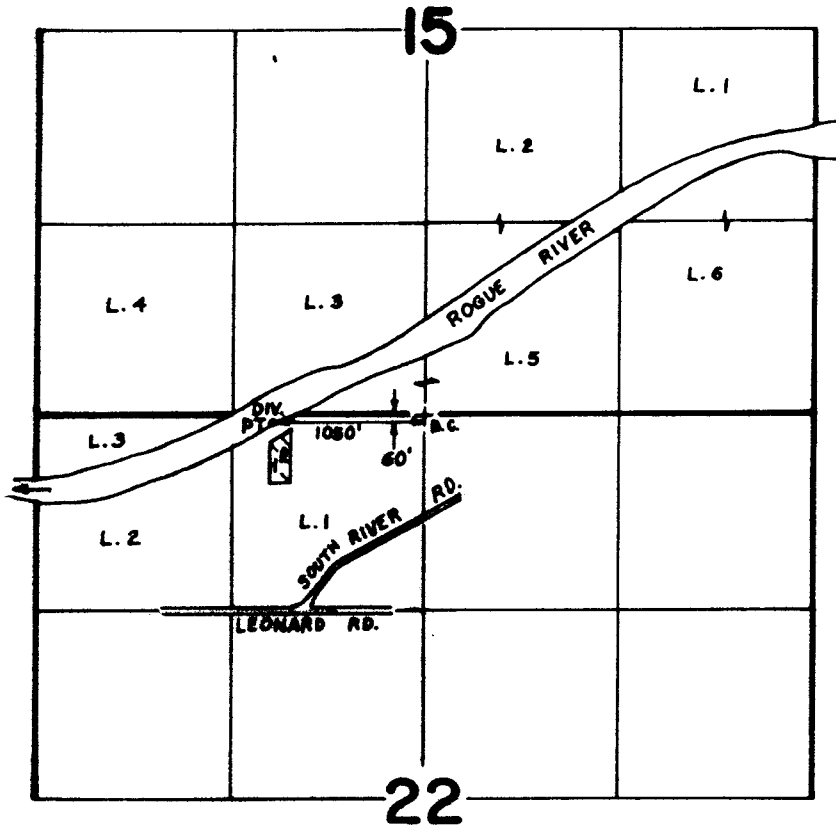

SCALE: 4" = 1 MILE

AUG 24 1989
 STATE OF OREGON

FINAL PROOF SURVEY
UNDER

Application No. 57643 Permit No. 43423
IN NAME OF

STEPHANIE R. MOFFETT

Surveyed JAN. 18. 19.84, by B. S. JAMES

B50-5-14 *twb*