


RECEIVED

AUG 29 1978

WATER RESOURCES DEPT.
SALEM, OREGON

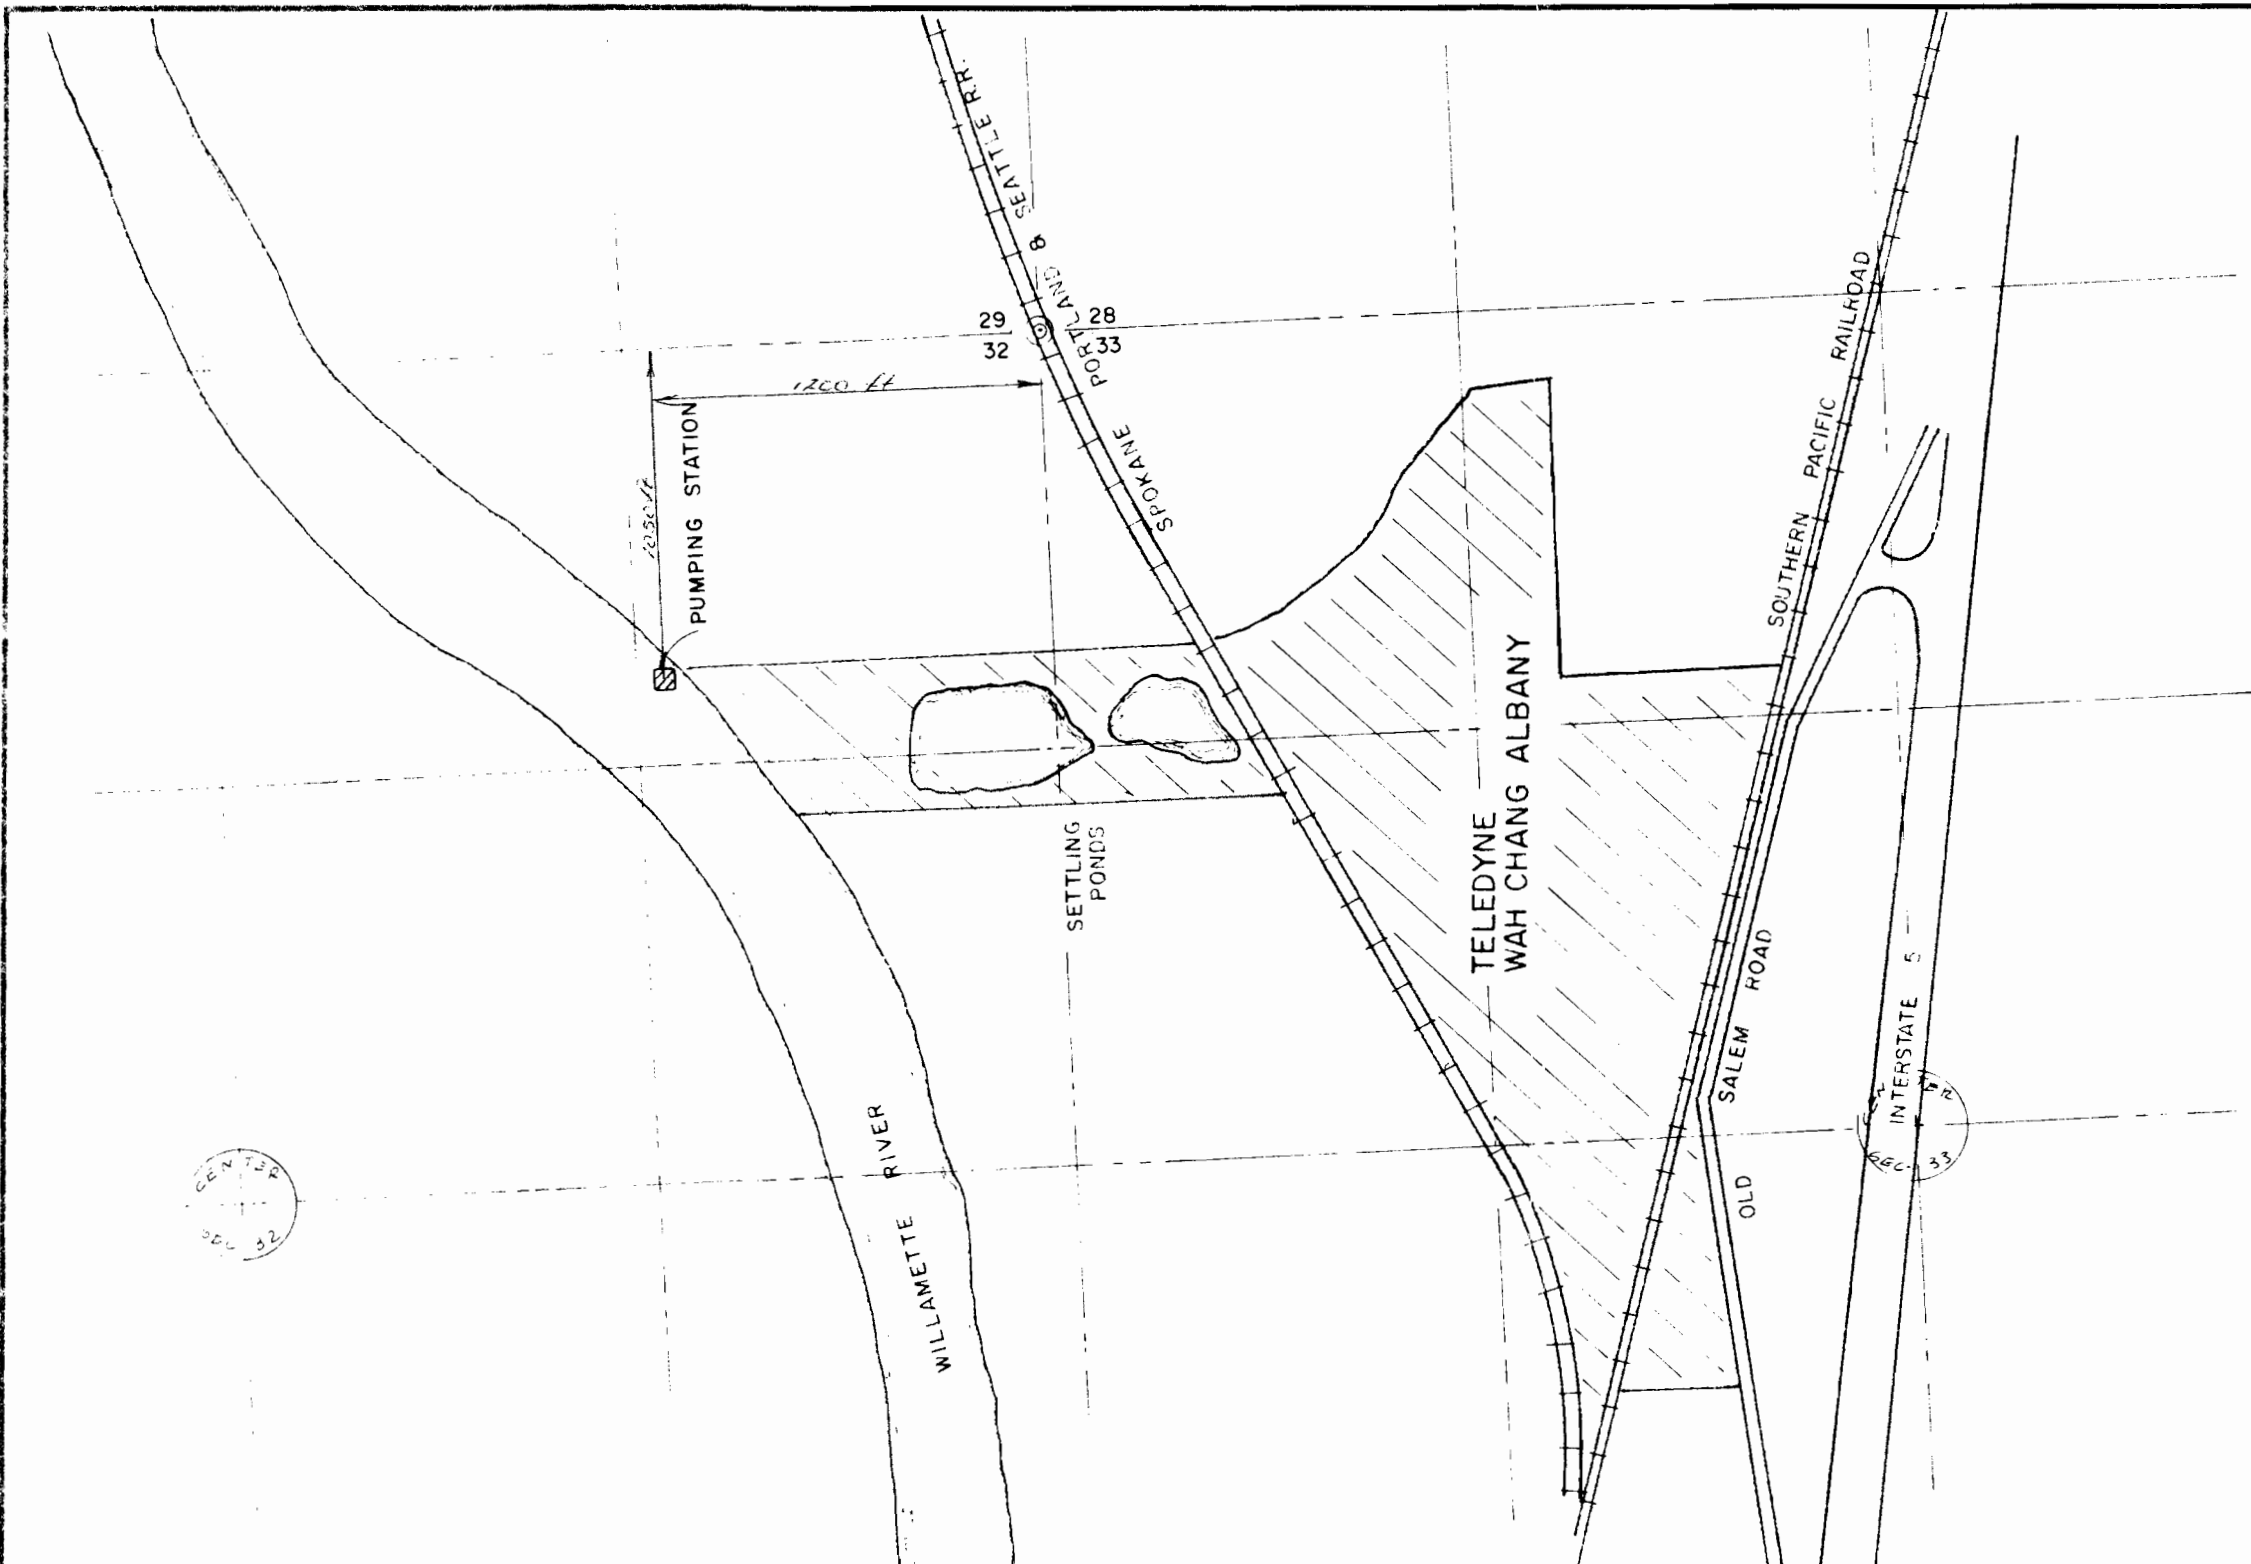

Application No. 56919
Permit No. 43439

REFERENCE ONLY

NOTICE

This document contains proprietary information of Teledyne Wah Chang which is not to be copied or used in any way without the express written permission of Teledyne Wah Chang.

Any questions regarding dimensioning of this drawing should be directed to the engineering department, Wah Chang Albany.

REVISIONS			
NO	DATE	REMARKS	APP'D
1			
2			
3			
4			
5			

REFERENCE DRAWING	
NUMBER	DESCRIPTION

ALLOWED TOLERANCES	
FRACTION (MACH)	± 1/32"
(FAB)	± 1/8"
2 DECIMAL PLACES	± 0.01
3 DECIMAL PLACES	± 0.005
4 DECIMAL PLACES	± 0.0005
ANGLE ± 30 MIN.	
UNLESS OTHERWISE SPECIFIED	

<p>TELEDYNE WAH CHANG ALBANY P.O. BOX 460 ALBANY, OREGON 97321</p>		
<p>PLOT PLAN (T. 105., R. 3W., W.M. LINN CNTY., ORE)</p>		
DESIGNED BY	SCALE 1" = 600'	MATERIAL
DRAWN BY D HAAKE	DATE 11-15-77	DRAWING NO.
CHK'D BY	APP'D BY	A-B9