


T. 38 S., R. 5 W., W. M.

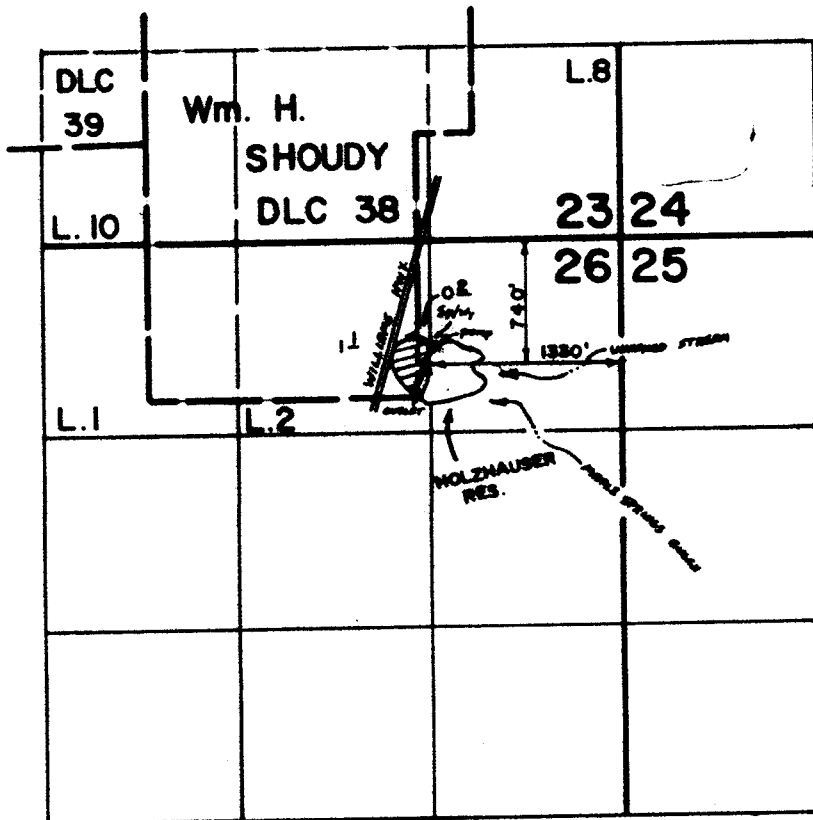

RECEIVED

JAN 18 1989

NOV 14 1988

**FINAL PROOF SURVEY**  
UNDER

Application No. **R-57062** Permit No. **R-7701**  
**57063** **43463**  
IN NAME OF

**JANEEN V. ARMBRUSTER**

Surveyed **AUG. 4, 1983**, by **R.S. JAMES**

SCALE: 4" = 1 MILE

179-108R